


G10
(2500 SF)

UNIT G30
(1,000 SF)

UNIT G1
(1300 SF)

GROUND
FLOOR

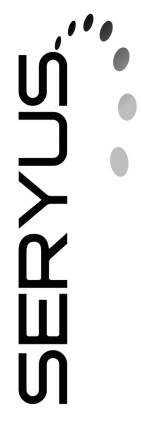


SCALE 1/8"=1'-0"
D.HOWARD
2/15/2013

139 RALPH MCGILL BLVD ATLANTA, GEORGIA



SCALE 1/8" = 1'-0"
D. HOWARD
2/15/2013


139 RALPH MCGILL BLVD ATLANTA, GA

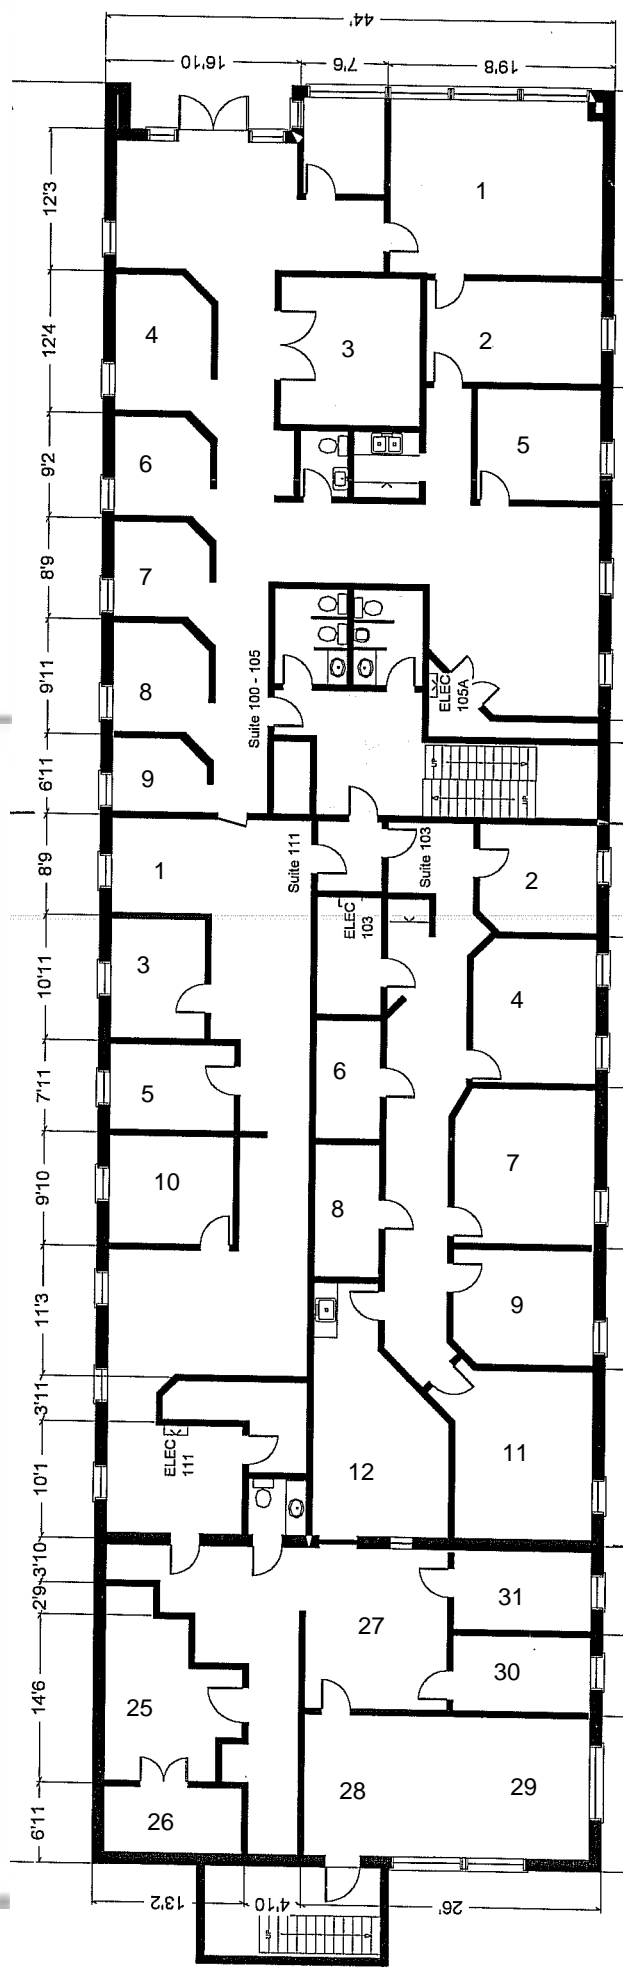

UNIT 1A
(2600 SF)

UNIT 1M
(1800 SF)

UNIT 1R
(800 SF)

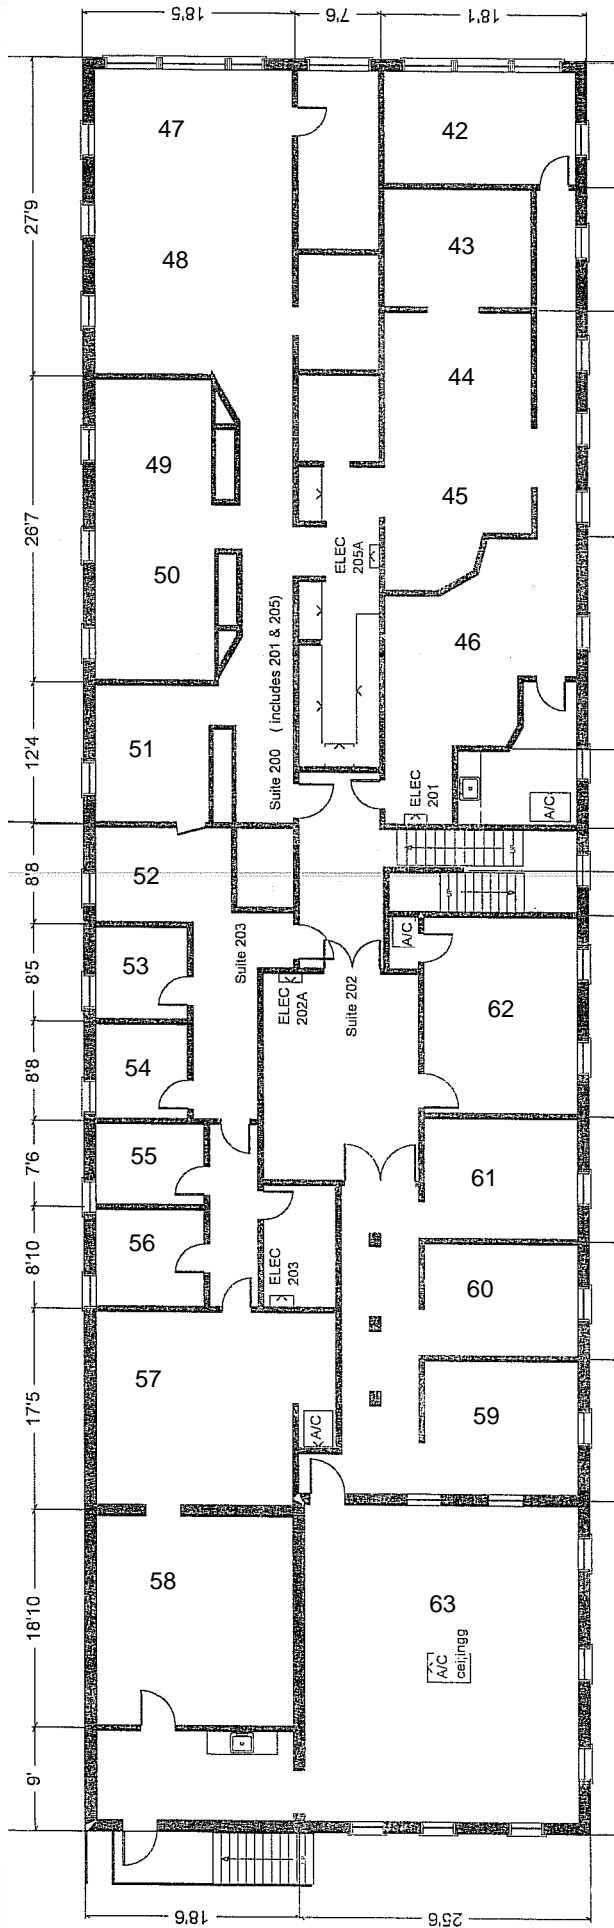

UNIT 2A
(3750 SF)

UNIT 2B
(2500 SF)

SECOND
FLOOR

GA 30340

SERYUS

scale 1/8" = 1'-0"

D. Howard
2/15/2013

139 RALPH MCGILL BLVD ATLANTA, GA