


FIRST FLOOR PLAN

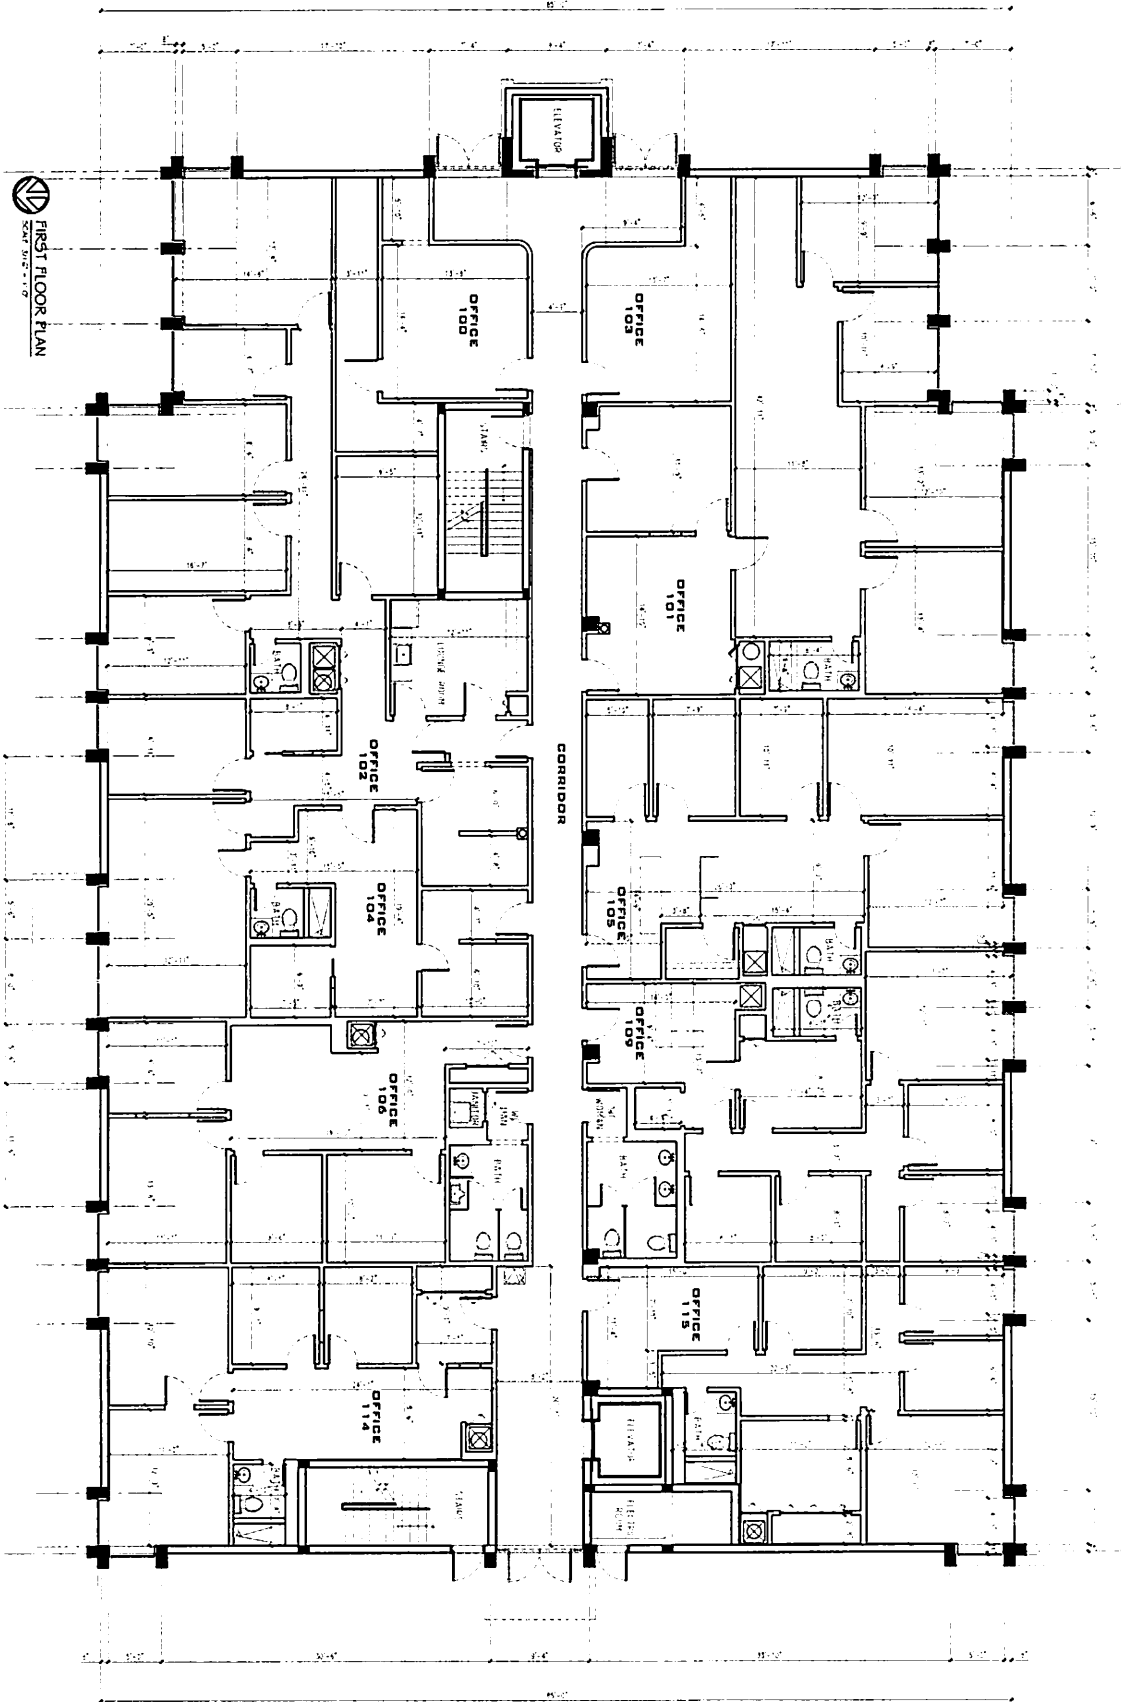


SHEET
A-1.0
 FIRST FLOOR PLAN
 AS SHOWN

CRISTINA FANDINO AIA
 A.R. No. 0014682
 5940 S.W. 73 ST. MIAMI,
 FLORIDA 33173
 DATE: MARCH 2012
 DRAWN BY: C. B.
 PROJECT MANAGER: CESAR BOTERO

1414 PROPERTY, LLC
 AS BUILT PLANS
 1414 NW 107 Avenue
 Sweetwater, FL 33172

1414 PROPERTY, LLC
 1414 NW 107 Avenue
 Sweetwater, FL 33172

REVISIONS

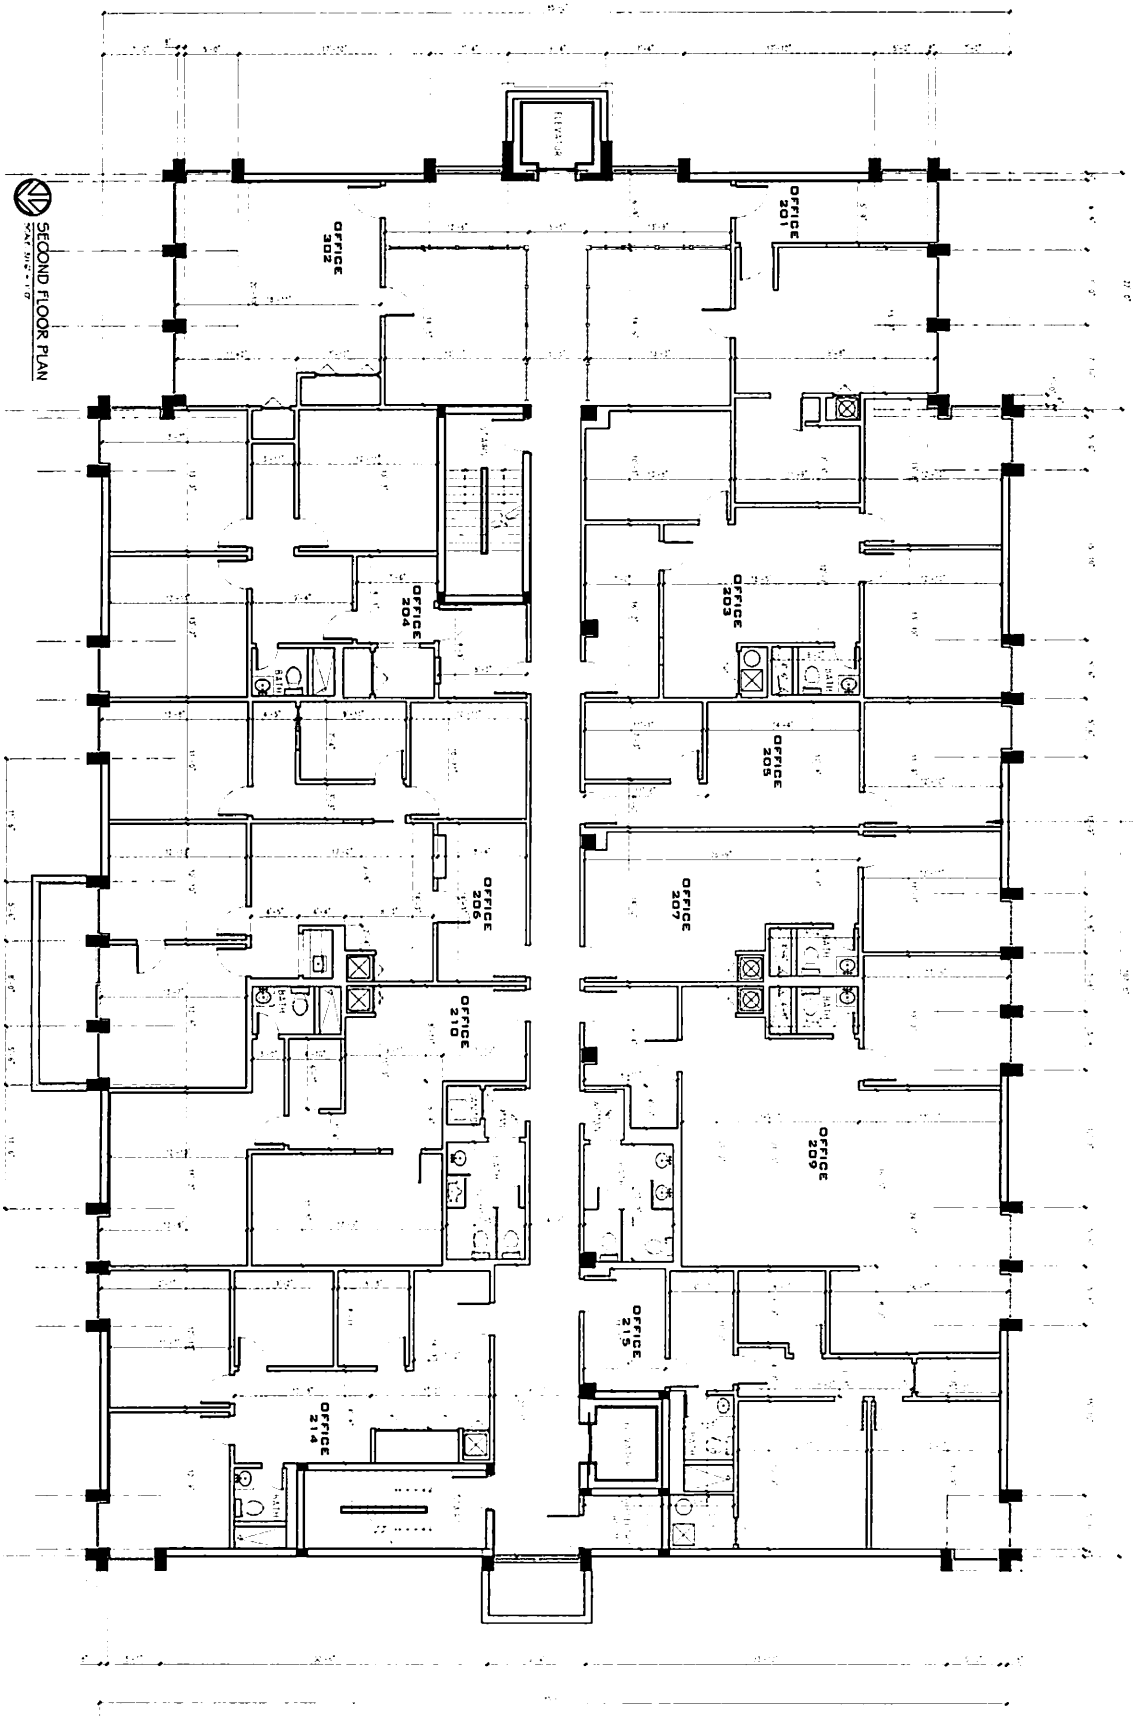

SECOND FLOOR PLAN


SHEET
A-20
OF
SECOND FLOOR PLAN
AS BUILT

CRISTINA FANDIÑO AIA
A.R. No. 0014682
5940 S.W. 73 St. MIAMI,
FLORIDA 33173
DATE: March 2012
DRAWN BY: C. B.
PROJECT MANAGER: CESAR BOTERO

1414 PROPERTY, LLC
AS BUILT PLANS
1414 NW 107 Avenue
Sweetwater, FL 33172

1414 PROPERTY, LLC
1414 NW 107 Avenue
Sweetwater, FL 33172

REVISIONS

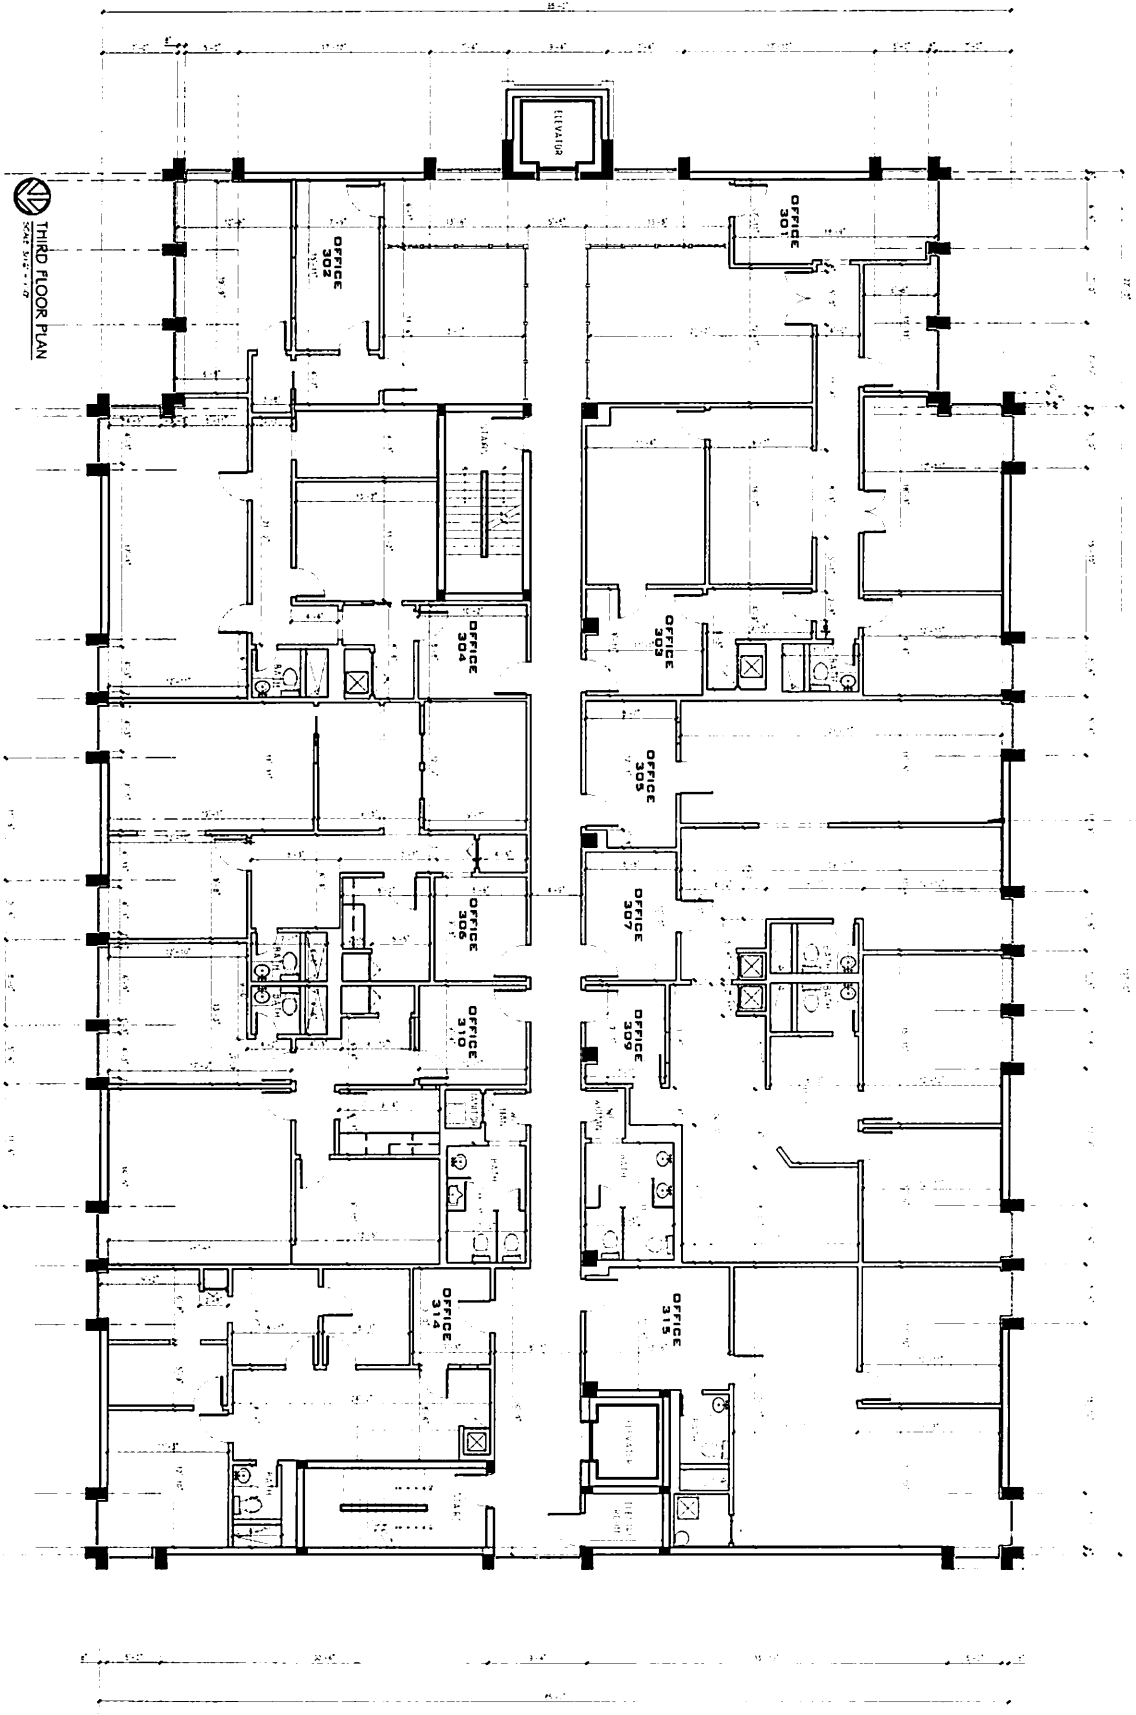

THIRD FLOOR PLAN
SCALE: 1/8" = 1'-0"

THIRD FLOOR PLAN
AS BUILT

CRISTINA FANDINO AIA
A.R. No. 0014682
5940 S.W. 73 ST. MIAMI,
FLORIDA 33173


DATE: March 2012
DRAWN BY: C. B.
PROJECT MANAGER: CESAR BOTERO

1414 PROPERTY, LLC
AS BUILT PLANS
1414 NW 107 Avenue
Sweetwater, FL 33172

1414 PROPERTY, LLC
1414 NW 107 Avenue
Sweetwater, FL 33172

REVISIONS

FOURTH FLOOR PLAN

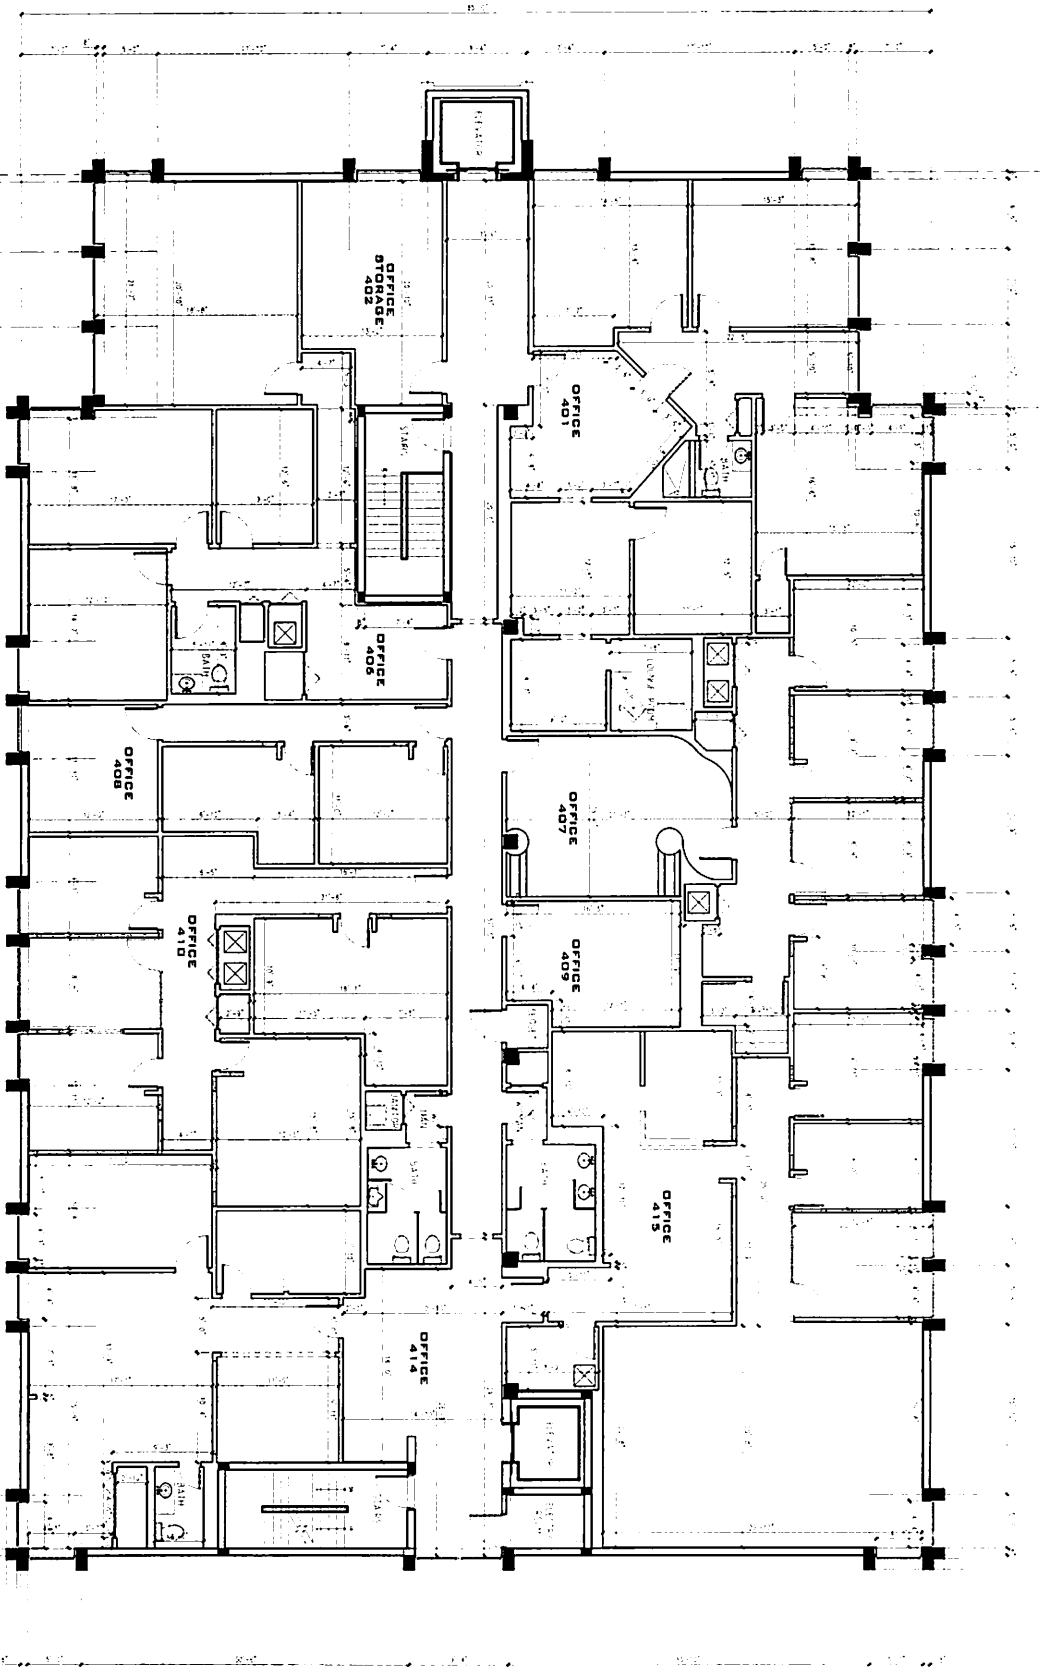

1414 PROPERTY, LLC

FOURTH FLOOR PLAN
 SHEET
 A-4.0
 OF
 14

CRISTINA FANDINO AIA
 A.R. No. 0014682
 5940 S.W. 73 ST. MIAMI,
 FLORIDA 33173
 DATE: March 2012
 DRAWN BY: C.B.
 PROJECT MANAGER: CESAR BOTERO

1414 PROPERTY, LLC
 AS BUILT PLANS
 1414 NW 107 Avenue
 Sweetwater, FL 33172

1414 PROPERTY, LLC
 1414 NW 107 Avenue
 Sweetwater, FL 33172

REVISED