


Floor Summary		SQ. FT.
Total Rentable Area		2,388
Total Occupant Area		2,178
Load Factor		1.0964

Floor Service Area	130
Building Service Area	0
Total Vertical	81

Suite #	Occupant Area	Rentable Area
Suite 201	1,176	1,289
Suite 202	1,002	1,099

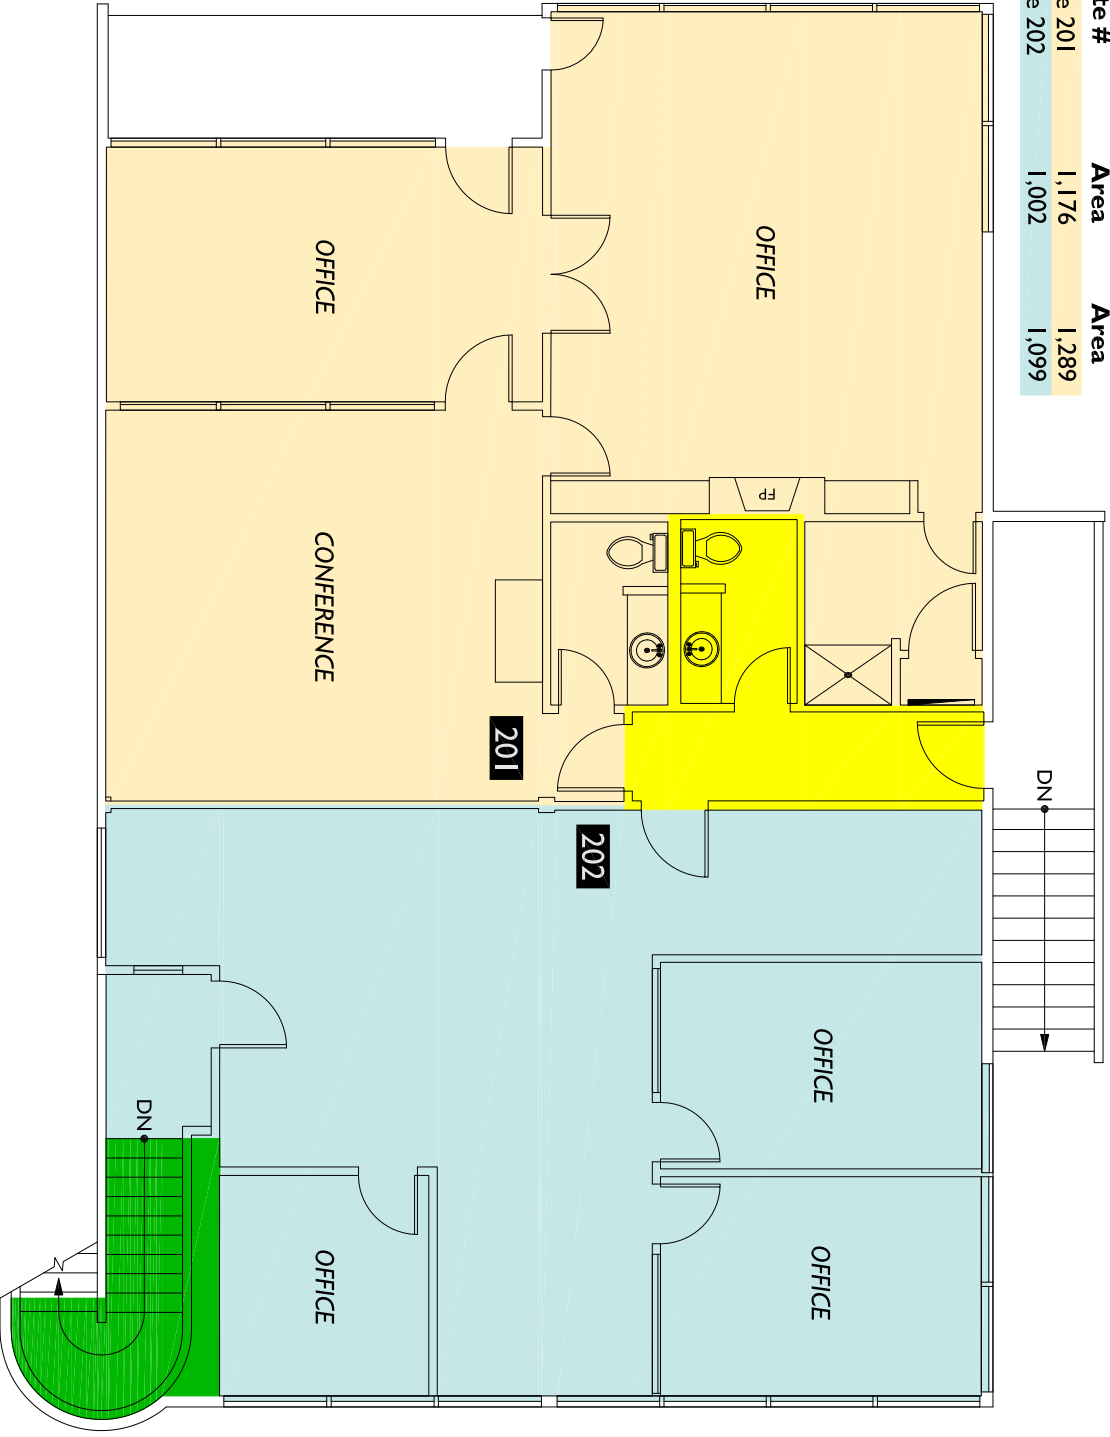

Vista Pacific Group  
 11251 120th Avenue NE Suite 206  
 Kirkland, WA 98033

Building A  
 2501 Mile Hill Drive  
 Port Orchard, WA 98366

Lease Plan  
**2**  
 Floor

Scale

**2D** ZDFLOORPLANS.COM  
 206-328-7410 fax 206-328-4764  
 AS-BUILT FLOOR PLANS  
 1700 21st Avenue South Suite 100  
 Seattle, WA 98144  
 Measured: July 2011 Project: C11-308