


IF THIS SHEET DOES NOT MEASURE TO 8.5 x 11, IT HAS BEEN ENLARGED OR REDUCED. ADJUST SCALE ACCORDINGLY.

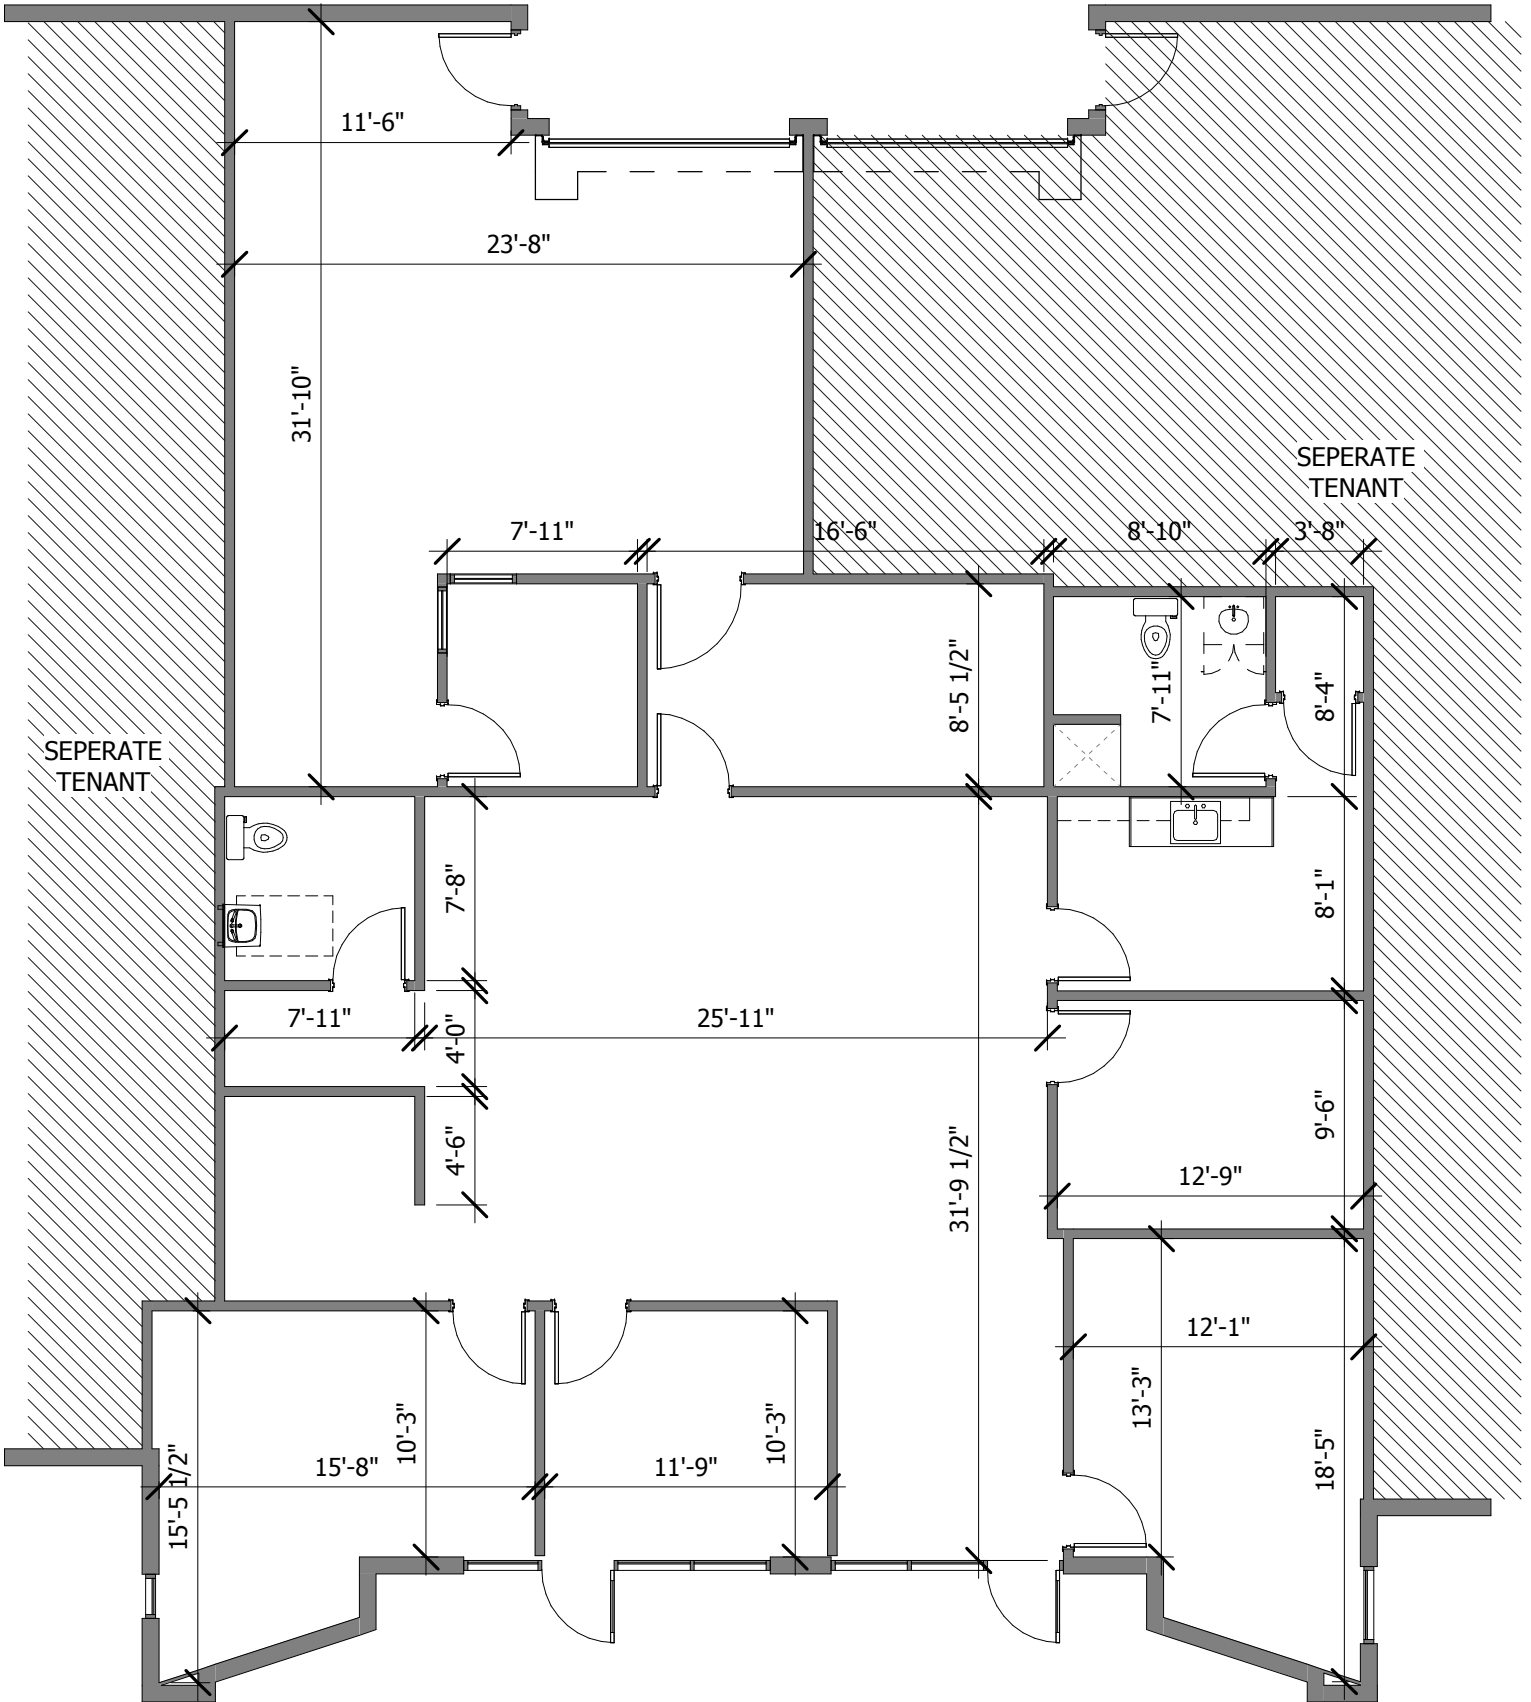

**SCOTT + CORMIA**

ARCHITECTURE + INTERIORS

429 S. Keller Road, Suite 200  
Orlando, Florida 32810  
t. 407-660-2766  
<http://www.scottcormia.com>  
© copyright 2018 All Rights Reserved

project

**QUORUM CENTER**  
H5-6A

seal

sheet info

PROJECT NUMBER 17005  
SHEET NAME AS-BUILT  
SHEET REF. #  
REF. #  
DRAWN BY KC  
CHECKED BY

4307 VINELAND ROAD  
ORLANDO, FL 32811

2018 NOV 7

**AB-01**