


SUITE 202 AS-BUILT FLOOR PLAN
WITHOUT DIMENSIONS 2,040 (+/-) SF
 SCALE - 1/4" = 1' - 0"

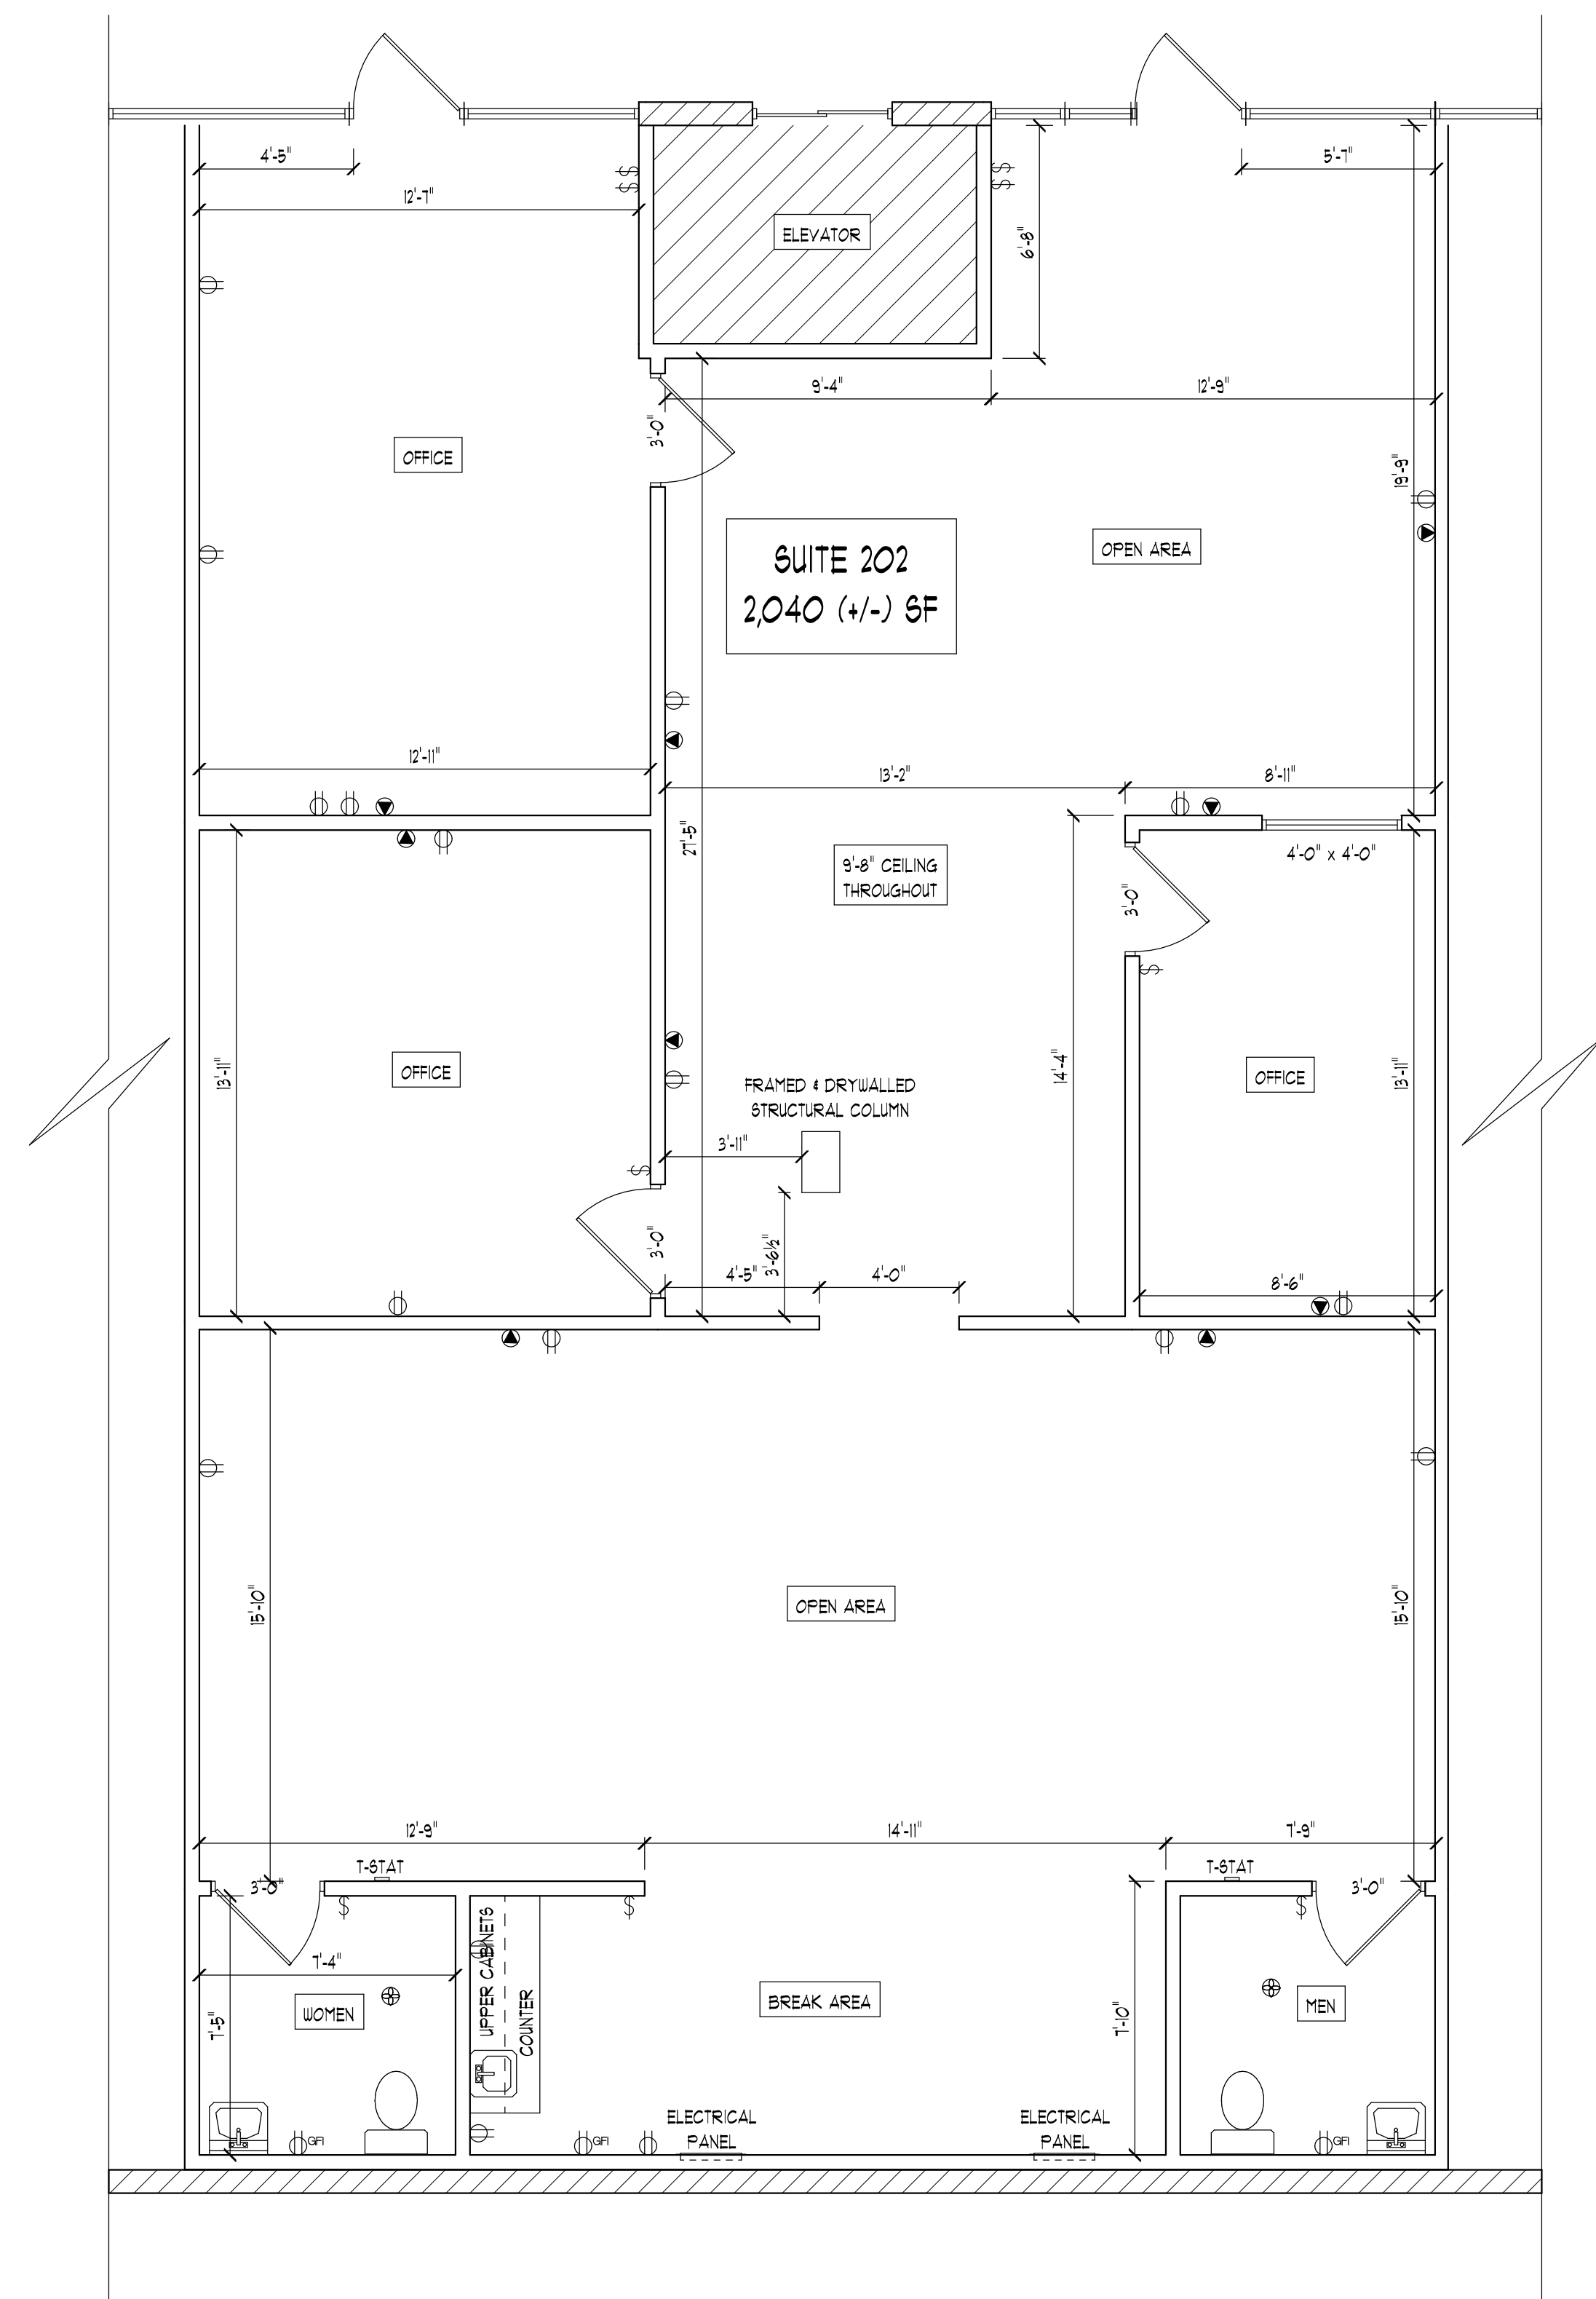

SUITE 202 AS-BUILT FLOOR PLAN
2,040 (+/-) SF
 SCALE - 1/4" = 1' - 0"

REVISIONS

© COPYRIGHT 2009

E. THUNDERBIRD SQUARE
 14202 N. Scottsdale Rd.
 Scottsdale, AZ 85254

SUITE 202 AS-BUILT
FLOOR PLAN

PREPARED BY:
 Harry Young, Design & Drafting
 602.909.6989
 www.HarryYoungDrafting.com

DRAWN BY:
 HARRY YOUNG

SCALE:
 1/4" = 1'-0"

DATE:
 01-09-11

SHEET NUMBER