



Adjacent Suite

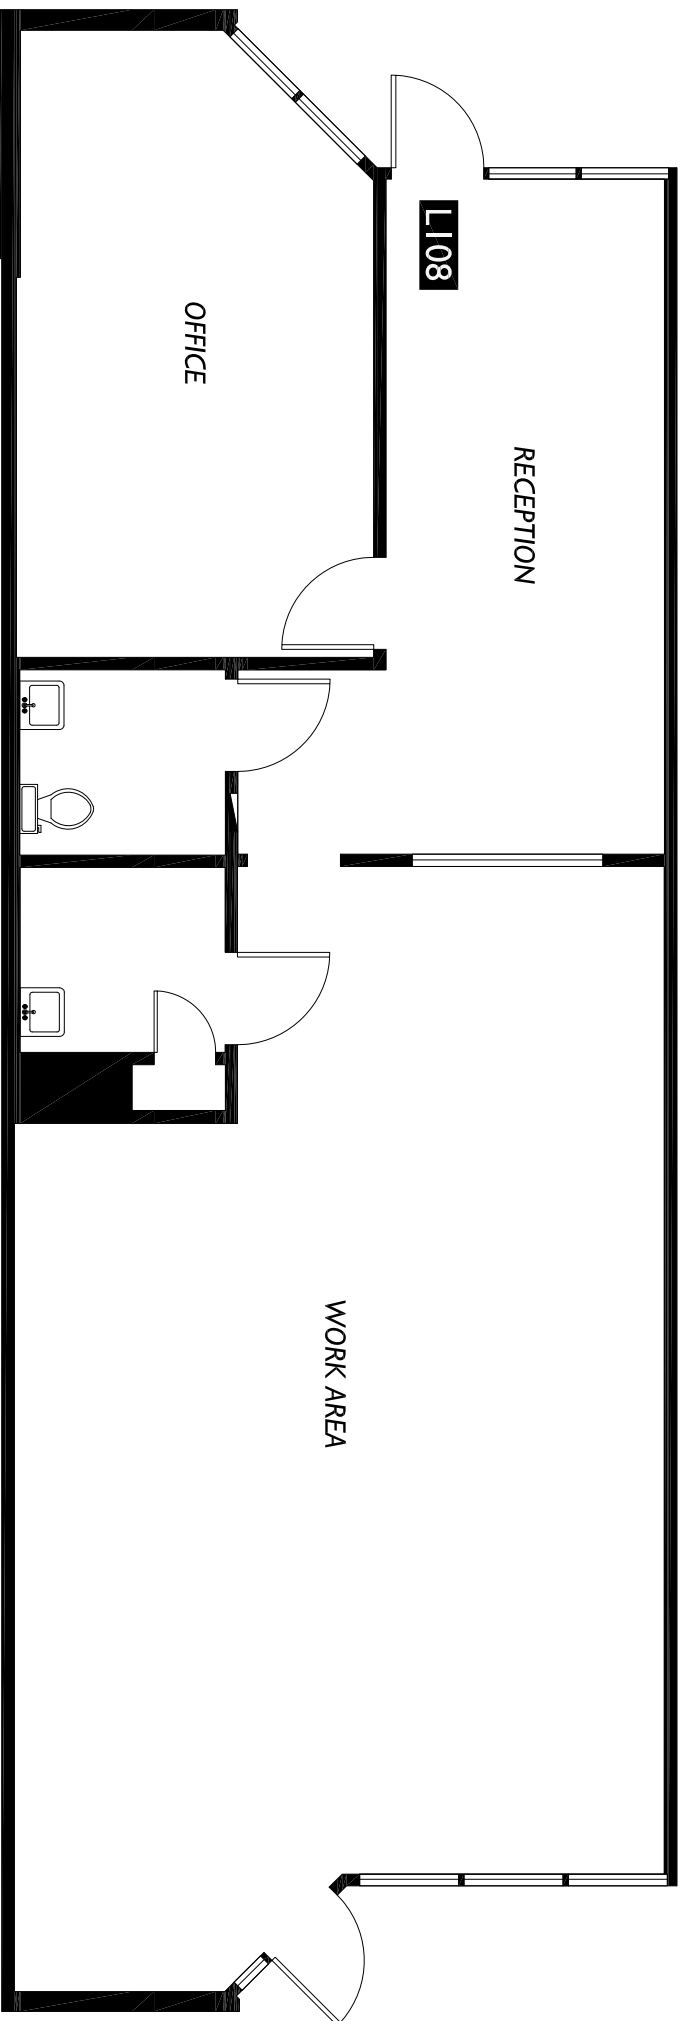

Adjacent Suite

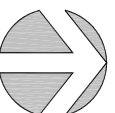

West Valley Business Park 2265 S. 190th Street Suite B-104 Kent, WA 98032		West Valley Business Park 2265 S. 190th Street Kent, WA 98032	
Client		Subject	
Suite Plan		Suite	
L108		L108	
Scale			
Measured: October 2014		Project: C14-662	

ZPD 2DFLOORPLANS.COM
206-328-7410 fax 206-328-4764
AS-BUILT FLOOR PLANS
1700 21st Avenue South Suite 100
Seattle, WA 98144