


As-Built

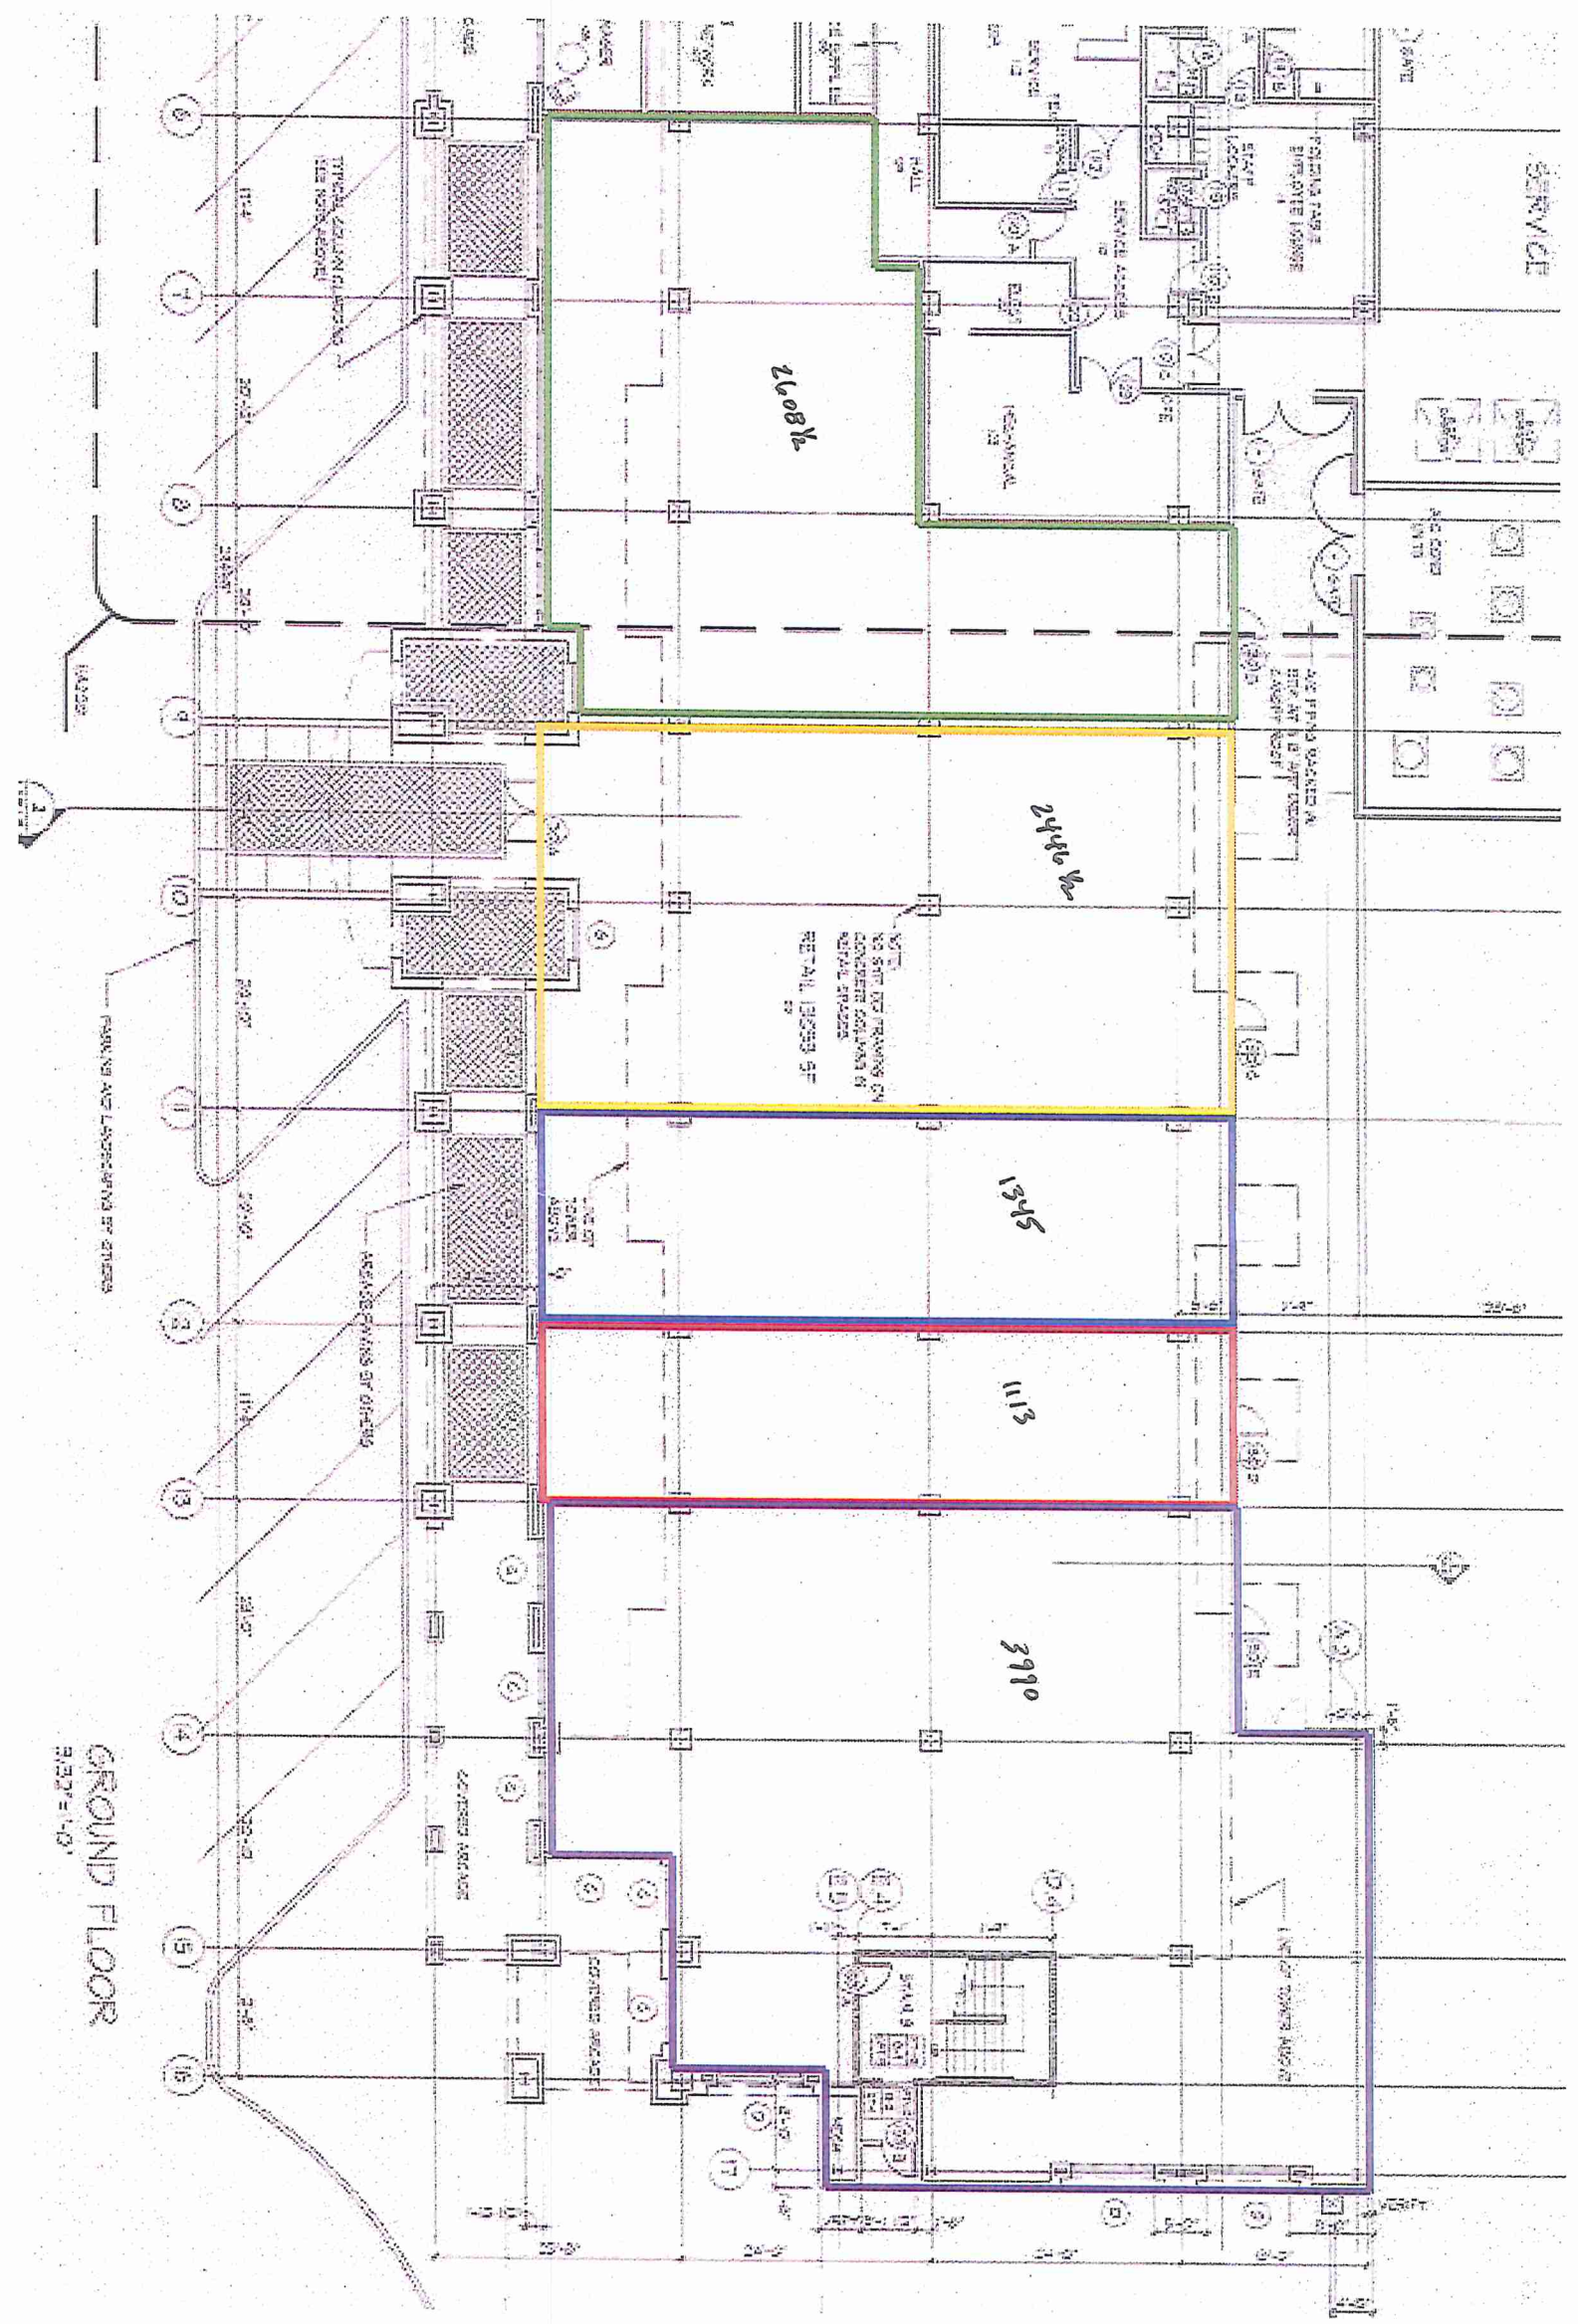

GROUND FLOOR
3/27/10