


# COMMERCE PARK

8406 Sterling, Irving, Texas

SUITE 8406  
4,745 RSF

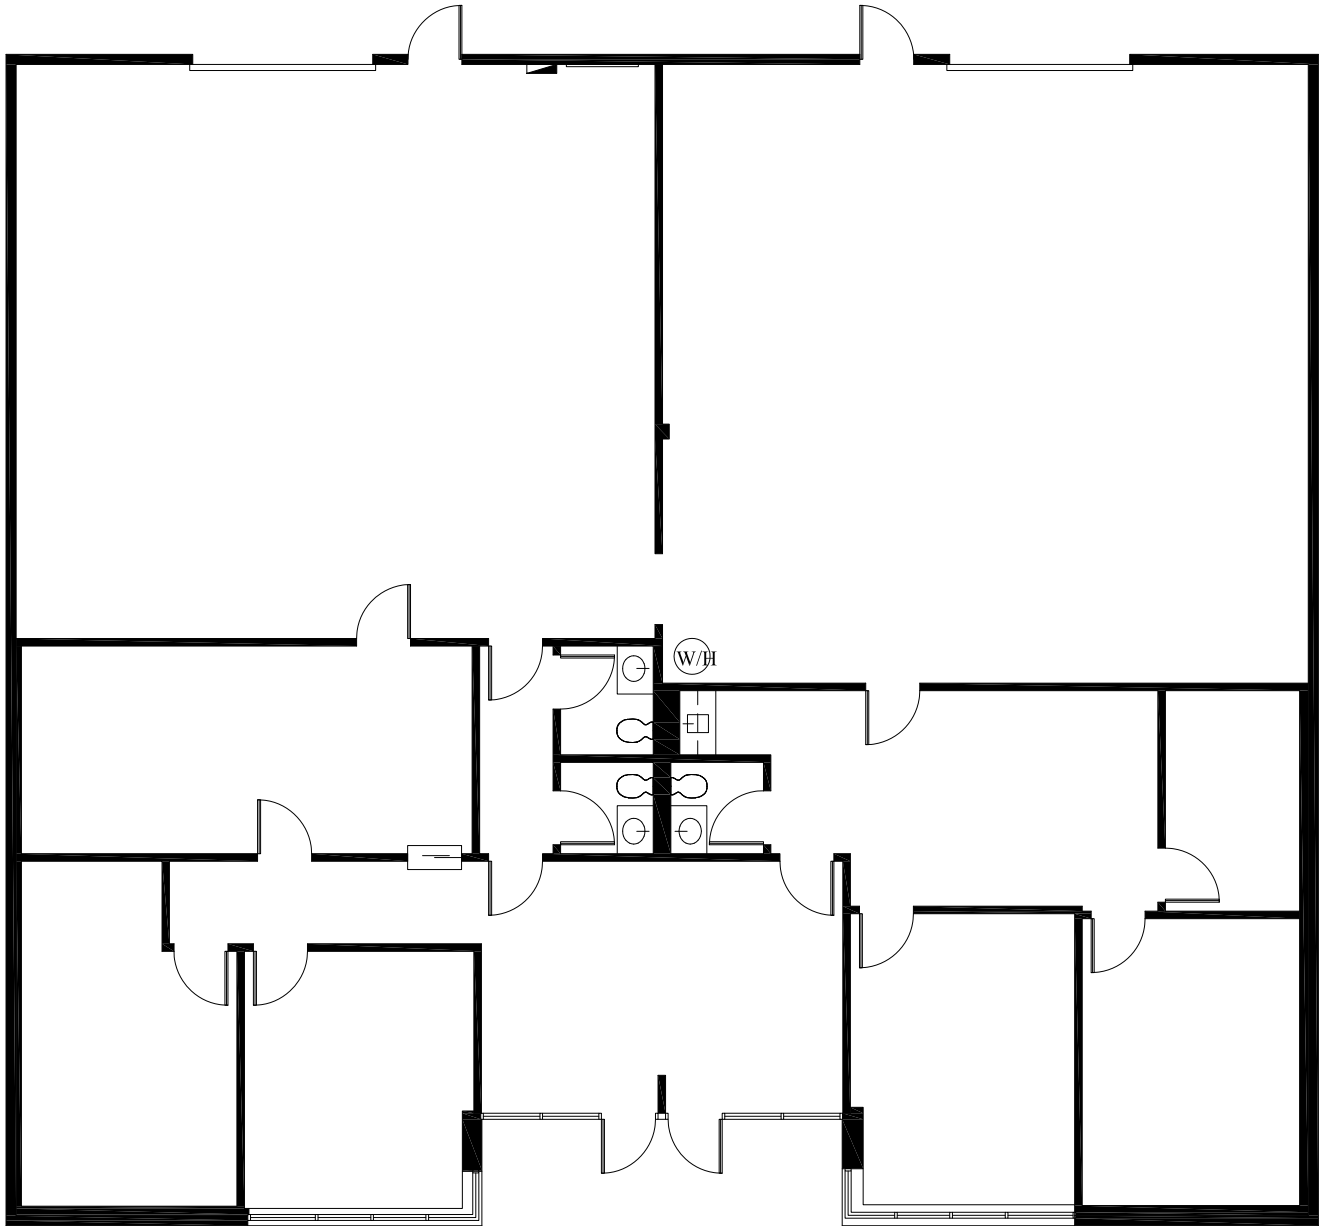

Call or Email Kolby Dickerson - [214-534-1599](tel:214-534-1599) ; [kdickerson@txreproperties.com](mailto:kdickerson@txreproperties.com)

Call or Email Cole Moreano - [214-995-1797](tel:214-995-1797); [cmoreano@txreproperties.com](mailto:cmoreano@txreproperties.com)