

## 903 PEACHTREE SHOPS

903 Peachtree St NW  
Atlanta, GA 30309




903 Peachtree Shops, a 8,504 square foot, one story specialty retail center, is located at the intersection of Peachtree Street and Eighth Street. The center offers 31 surface parking spaces and features prominent signage on Peachtree Street in the Atlanta's Midtown Mile district.



Matt Rohrig  
(404) 403 1441  
gmrohrig@cartelgroup.com

**903 PEACHTREE SHOPS**

903 Peachtree St NW  
Atlanta, Georgia 30309

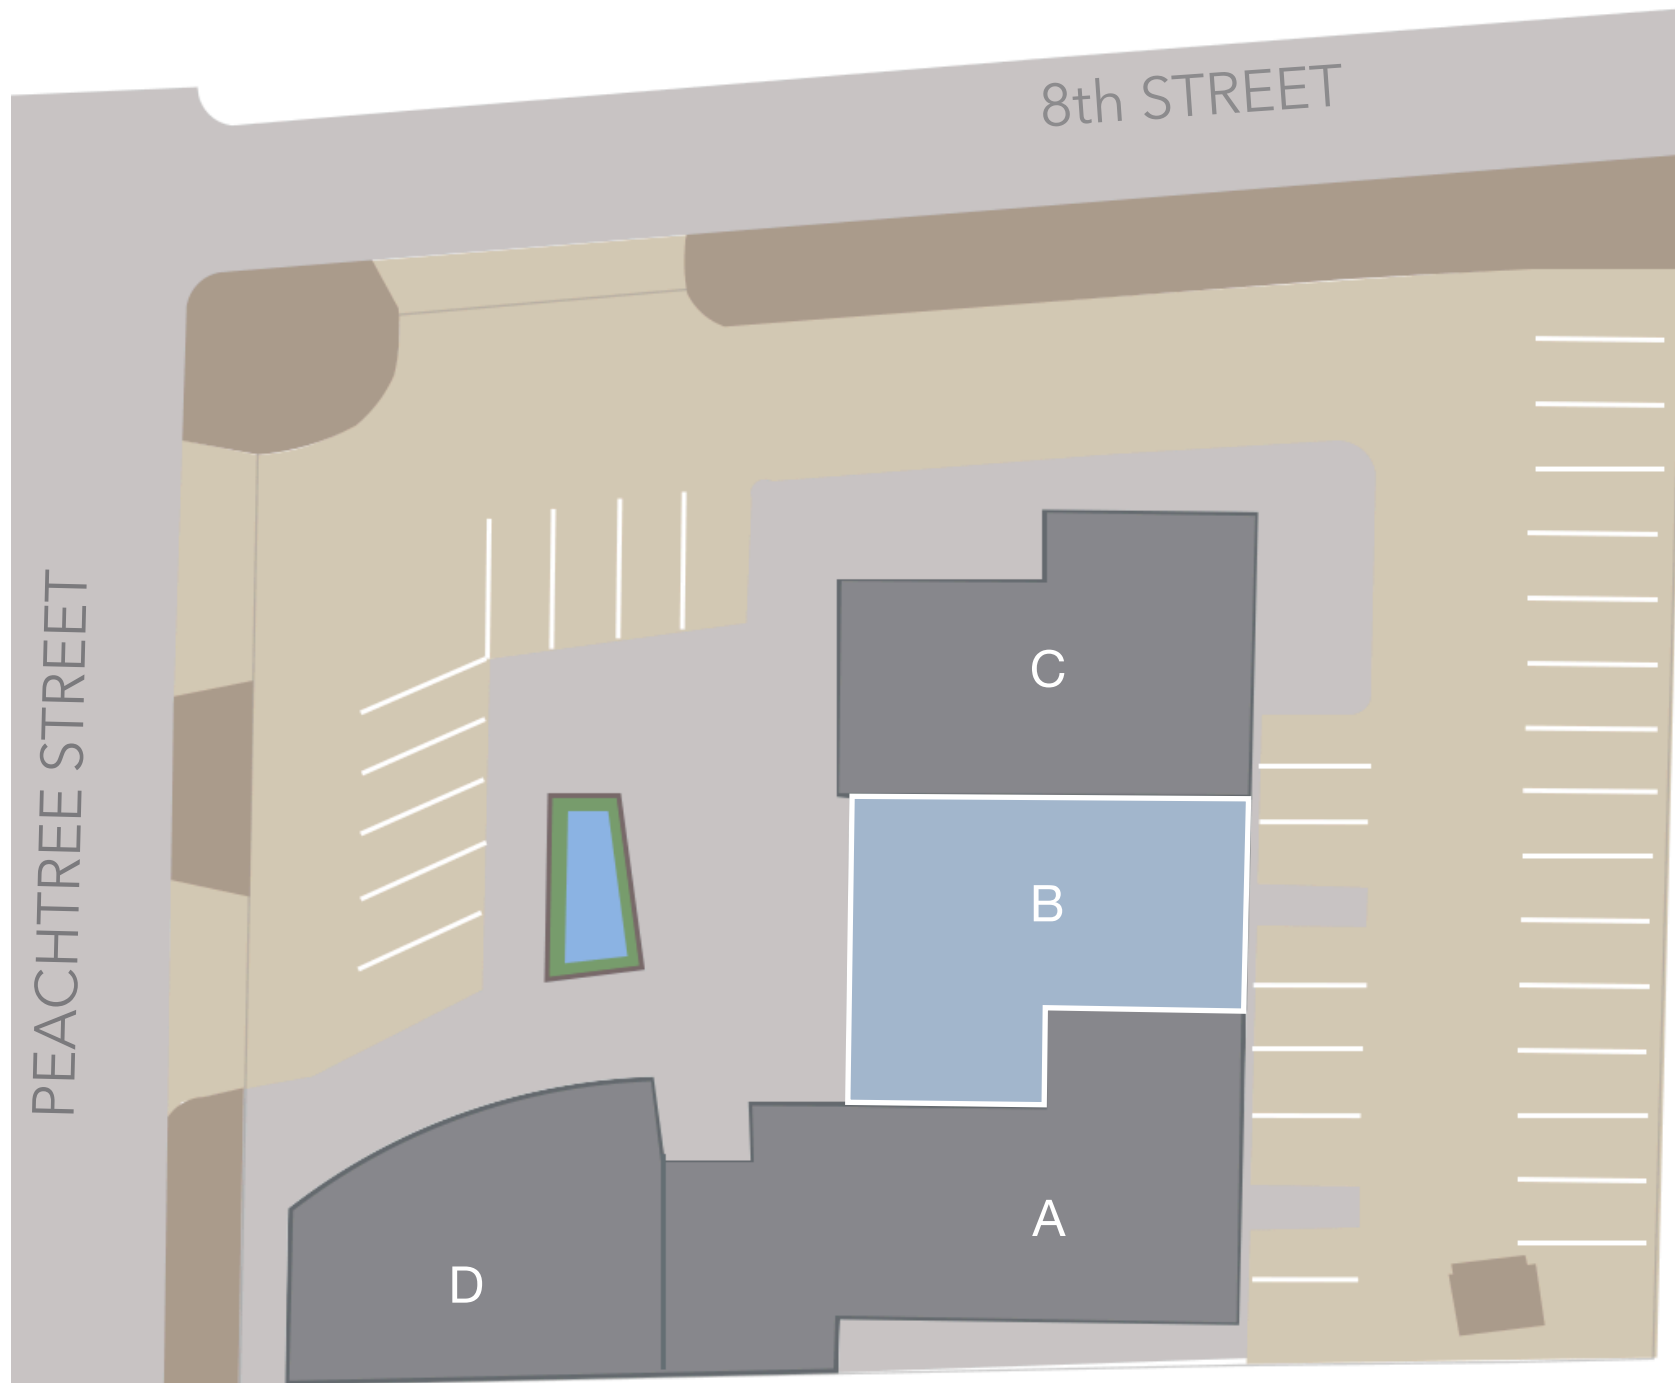

■ Available

Suite	Tenant
A	Noodle (2,464 sf)
B	<b>AVAILABLE (1,940 sf)</b>
C	Bezoria (2,000 sf)
D	T-Mobile (2,100 sf)

ZONING: SPI-3 ; Midtown District





# 903 PEACHTREE SHOPS

903 Peachtree St NW  
Atlanta, GA 30309

Matt Rohrig  
(404) 403 1441  
gmrohrig@cartelgroup.com






# 903 PEACHTREE SHOPS

903 Peachtree St NW  
Atlanta, GA 30309

Matt Rohrig  
(404) 403 1441  
gmrohrig@cartelgroup.com

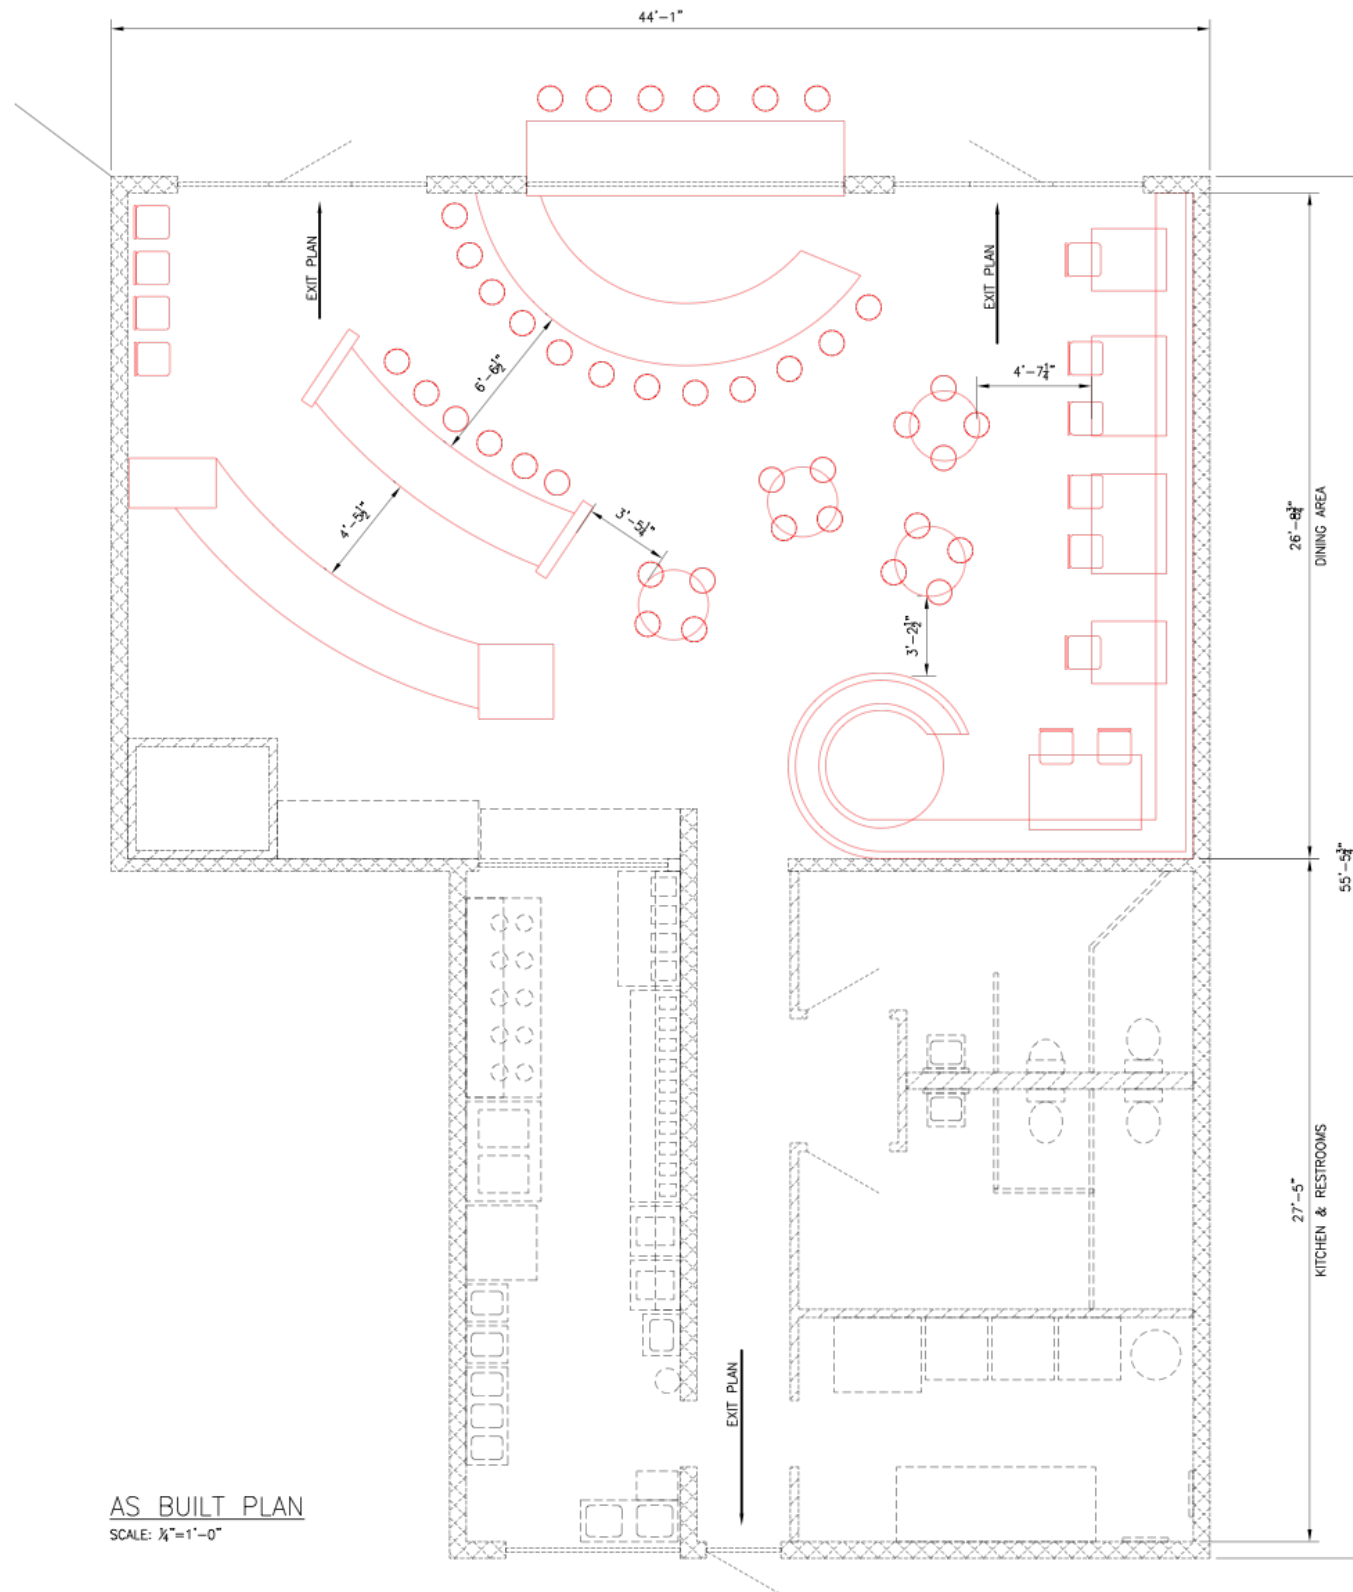

AS BUILT PLAN  
SCALE: 1/4"=1'-0"



ISSUED FOR CONSTRUCTION

903 PEACHTREE STREET

AS BUILT PLAN

SCALE NOTED  
DATE: 12/17/2012  
DRAWN BY: CAM  
CHECK BY: PDC

SE NUMBER: A-02-01  
SE FILE NAME: 12337.dwg  
STABILITY ENGINEERING

## 903 Peachtree Shops: SUITE B - FLOOR PLAN

REV	DESCRIPTION	DRWN	APPR	DATE	REV	DESCRIPTION	DRWN	APPR	DATE

431 Ponce de Leon Ave., Ste 4, Decatur, GA 30030 PH/Fax: 404-377-6916