For Lease

Retail Space

1540 Northwest Highway

Palatine, IL 60074



- Free-standing fast food restaurant with drive-thru available for lease
- ±3,062 SF located across from Arlington International Racecourse and Arlington Park Metra Station
- Close proximity to Route 53
- Arlington Park Ridership 35,982 passengers per day
- Union Pacific Northwest Line 11,301,755 passengers in 2015
- Area tenants include McDonald's, Dunkin' Donuts, Orbit Skate Center, Arlington International Racecourse and more

DEMOGRAPHIC SUMMARY			
	RADIUS		
	1 MILE	3 MILES	5 MILES
AVERAGE HHI	\$95,348	\$101,452	\$99,904
DAYTIME POPULATION	13,174	119,632	263,842
RESIDENTIAL POPULATION	11,392	130,236	285,828
TRAFFIC COUNTS			
NORTHWEST HIGHWAY			18,700 VPD
N. WILKE ROAD			14,900 VPD

Doug Renner 312.275.3137 doug.renner@baumrealty.com Mark Fredericks 312.275.3109 mark@baumrealty.com




For Lease

Retail Space

1540 Northwest Highway

Palatine, IL 60074

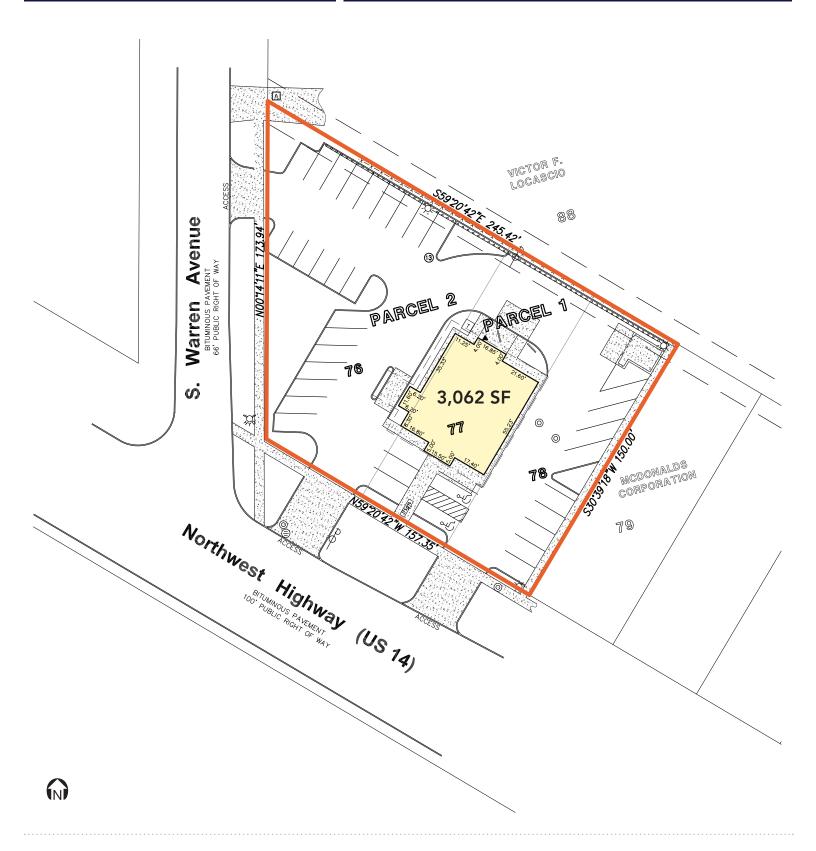

Doug Renner 312.275.3137 doug.renner@baumrealty.com Mark Fredericks 312.275.3109 mark@baumrealty.com




For Lease

Retail Space

1540 Northwest Highway

Palatine, IL 60074

As-Built Plan

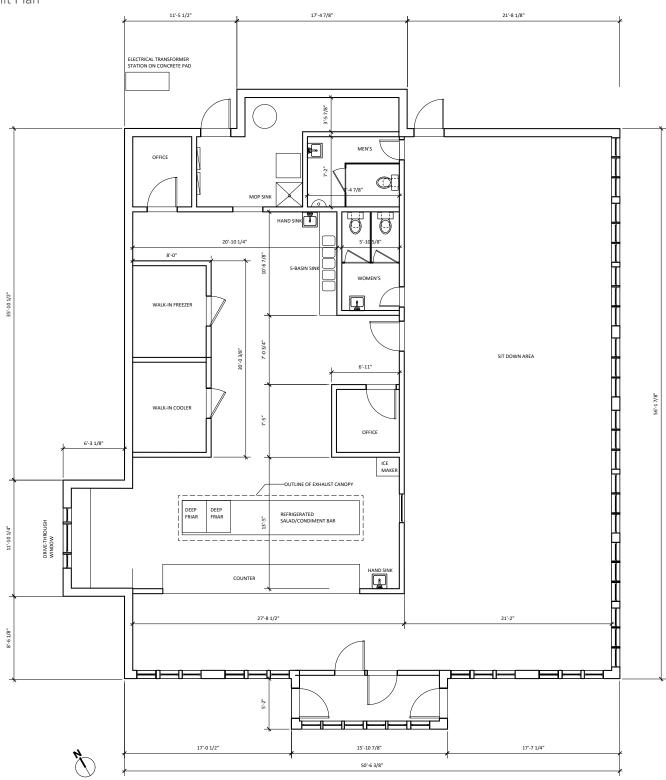

Doug Renner 312.275.3137 doug.renner@baumrealty.com Mark Fredericks 312.275.3109 mark@baumrealty.com





1540 Northwest Highway Palatine, IL



