


**NOTES**

1. ALL CALCULATIONS INDICATE "GROSS RETAIL" AREA AS PER "BOMA" STANDARDS.
2. ALL FIXTURES INDICATED ARE BUILT-IN.
3. ALL FLOORS ARE TILE UNLESS OTHERWISE INDICATED.
4. ALL CEILING HEIGHTS ARE 8'-0" UNLESS OTHERWISE NOTED.
5. ALL DIMENSIONS TO BE FIELD VERIFIED PRIOR TO ANY CONSTRUCTION.

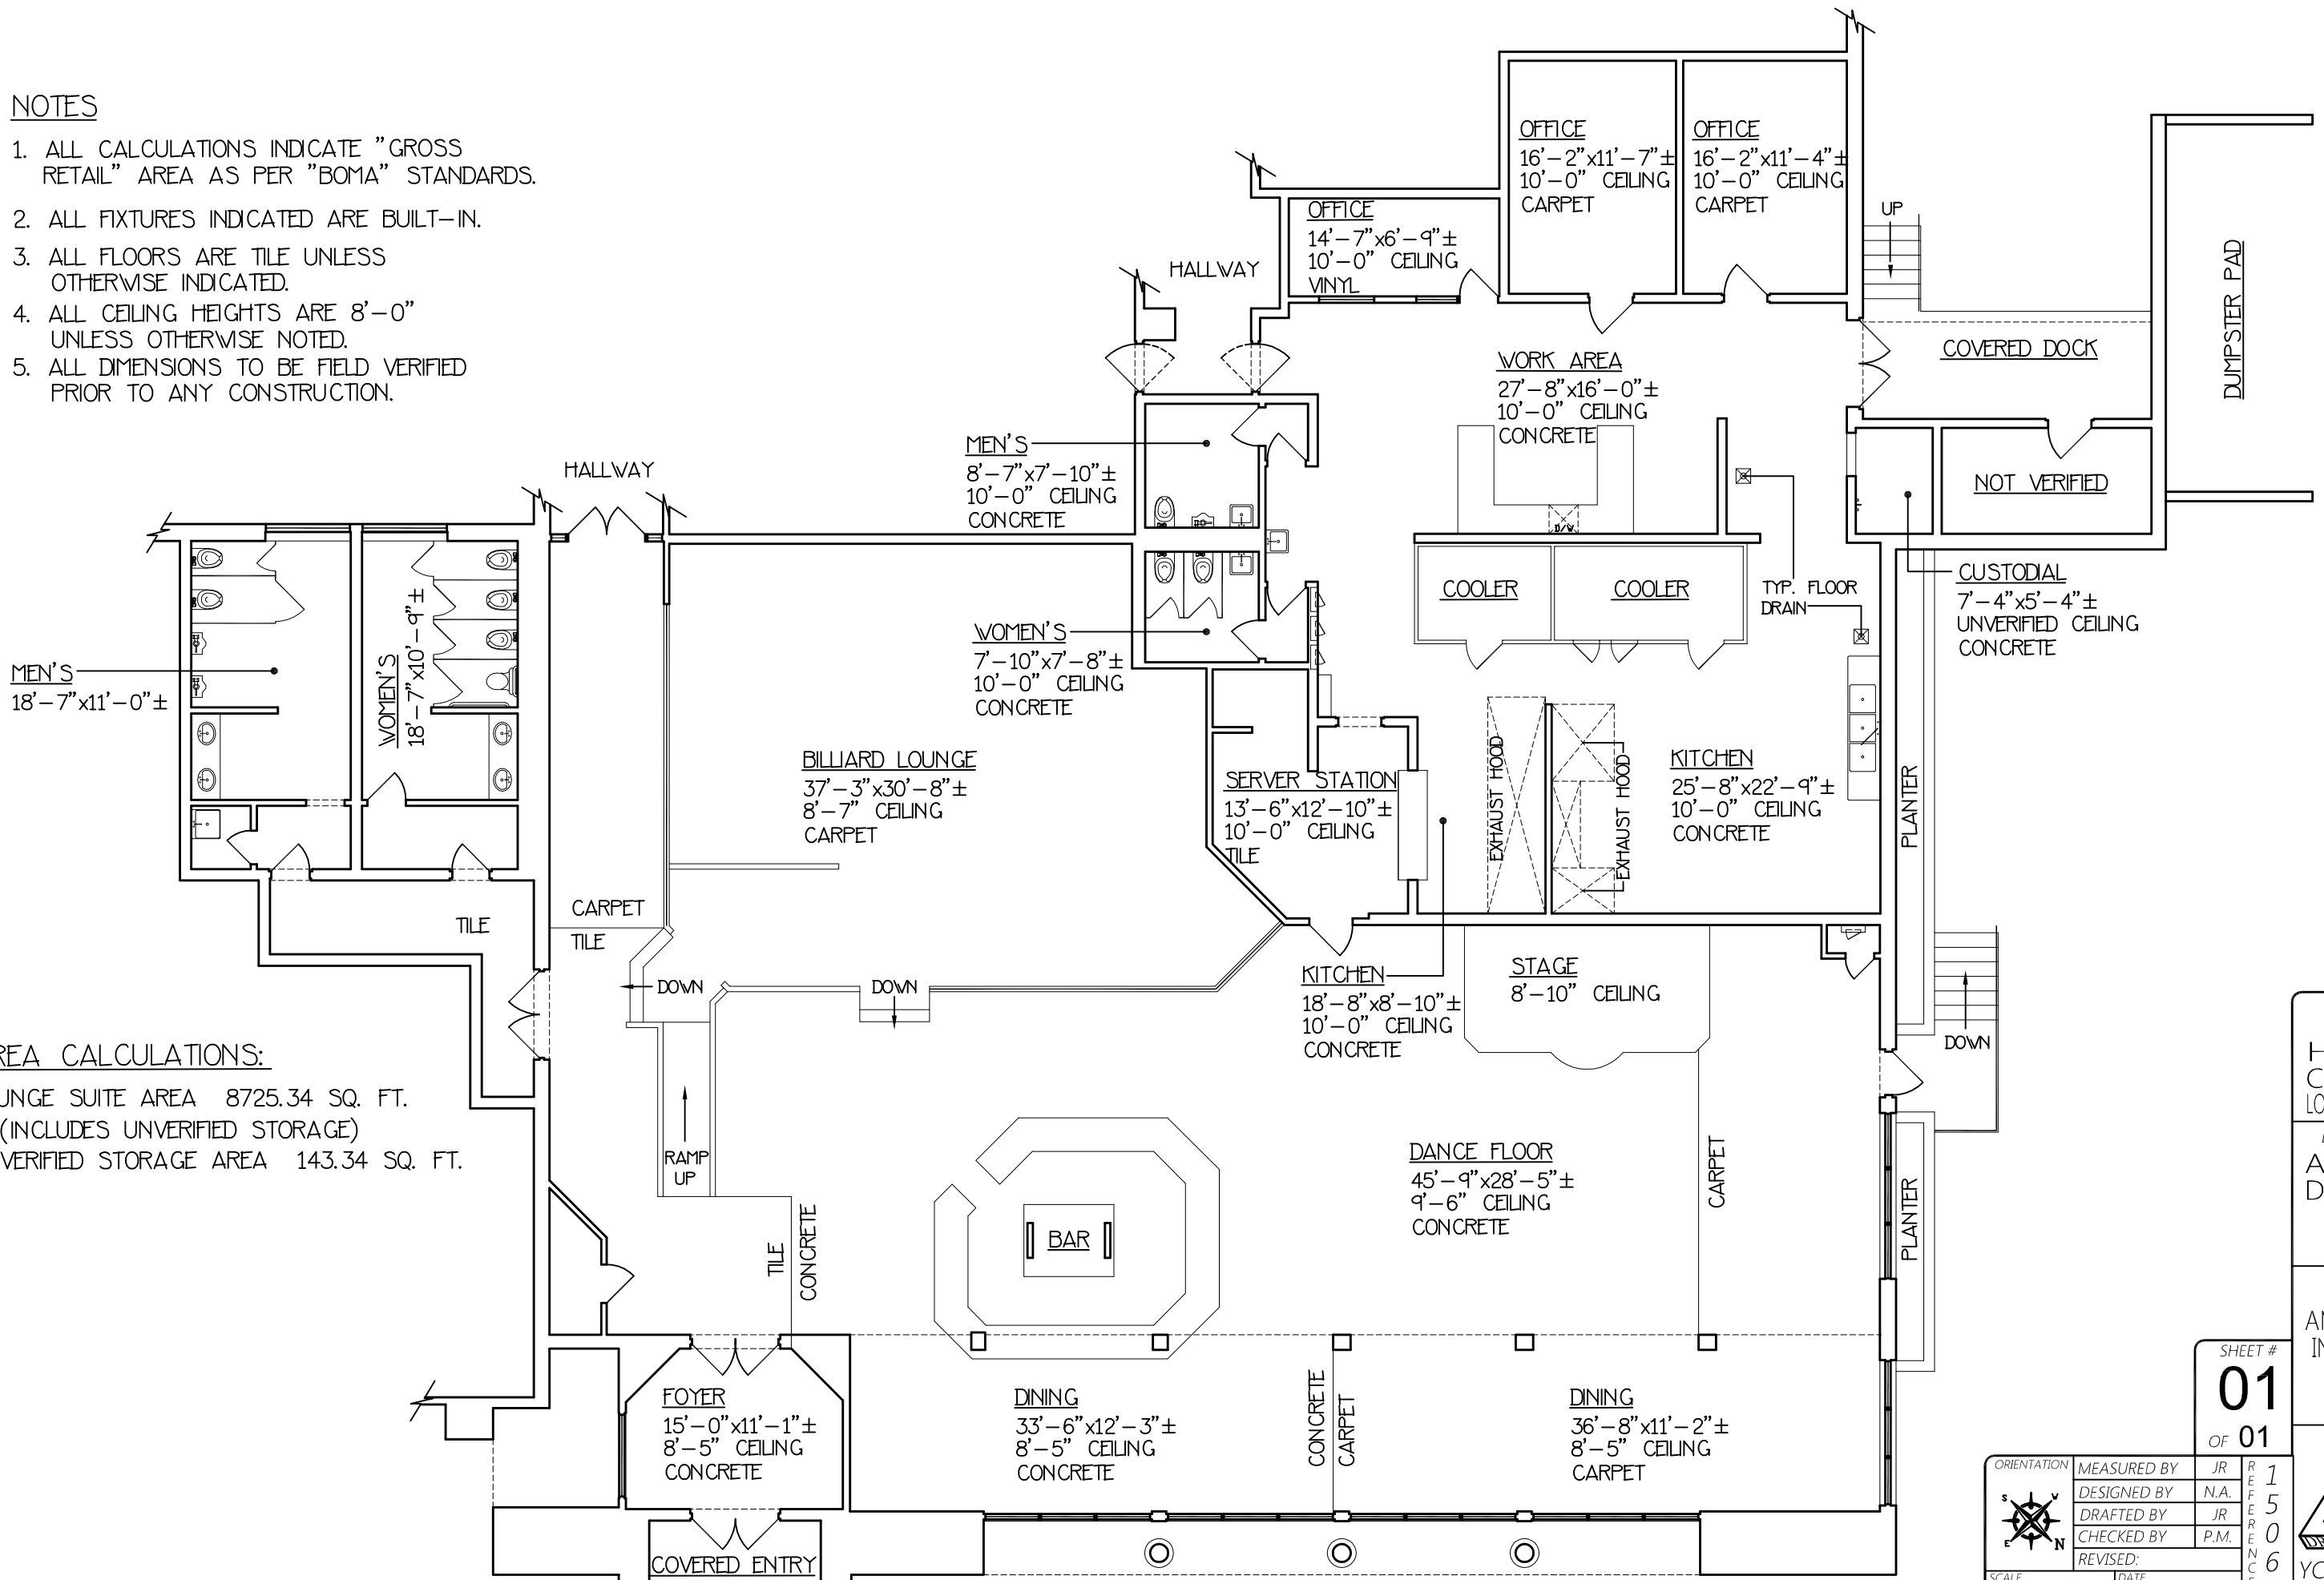

**AREA CALCULATIONS:**

LOUNGE SUITE AREA 8725.34 SQ. FT.  
 (INCLUDES UNVERIFIED STORAGE)  
 UNVERIFIED STORAGE AREA 143.34 SQ. FT.

PROJECT:  
**25 HOTEL CIRCLE NE LOUNGE PORTION**

DESCRIPTION:  
**AS-BUILT DRAWING**

CLIENT:  
**AMERSTONE INVESTMENT LLC**

SHEET #  
**01**  
 OF 01

ORIENTATION	MEASURED BY	JR	REFERENCE #	1
	DESIGNED BY	N.A.		5
	DRAFTED BY	JR		0
	CHECKED BY	P.M.		6
	REVISED:			7
SCALE	DATE			
3/32"=1'-0"	03/27/15			

