

# 1 FLOOR PLAN - As Built


SCALE: 1" = 10'-0"

**215 E. FREEMAN ST. Duncanville, TX**

The information contained herein was obtained from sources believed to be reliable; however RealSpace, LLC. makes no guarantees, warranties or representations as to completeness or accuracy thereof. All land, lot and square footage information is approximate. The presentation of these properties for sale, rent or exchange is submitted subject to errors, omissions, change of price, conditions, prior sale/lease or withdrawal without notice.

7/1/2009

**RS**  
RealSpace

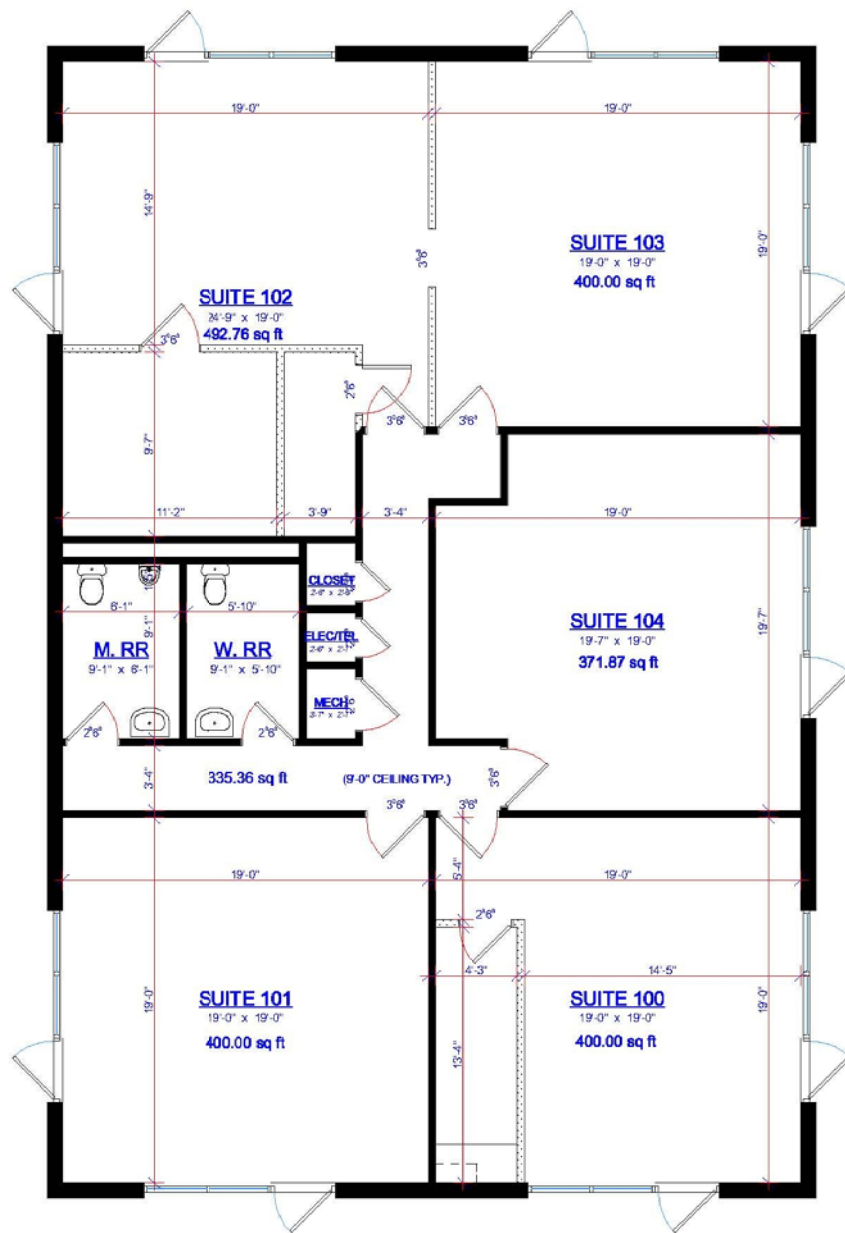

# 1 FLOOR PLAN

SCALE: 1" = 10'-0"

## 211 E. FREEMAN ST. Duncanville, TX

The information contained herein was obtained from sources believed to be reliable; however RealSpace, LLC, makes no guarantees, warranties or representations as to completeness or accuracy thereof. All land, lot and square footage information is approximate. The presentation of these properties for sale, rent or exchange is submitted subject to errors, omissions, change of price, conditions, prior sale/lease or withdrawal without notice.

7/1/2009

**RS**  
RealSpace