
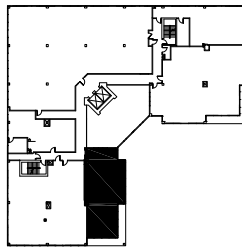


HIGHPOINT MEDICAL BUILDING

800 West Arbrook Boulevard, Arlington, Texas

SUITE 205
1,595 RSF

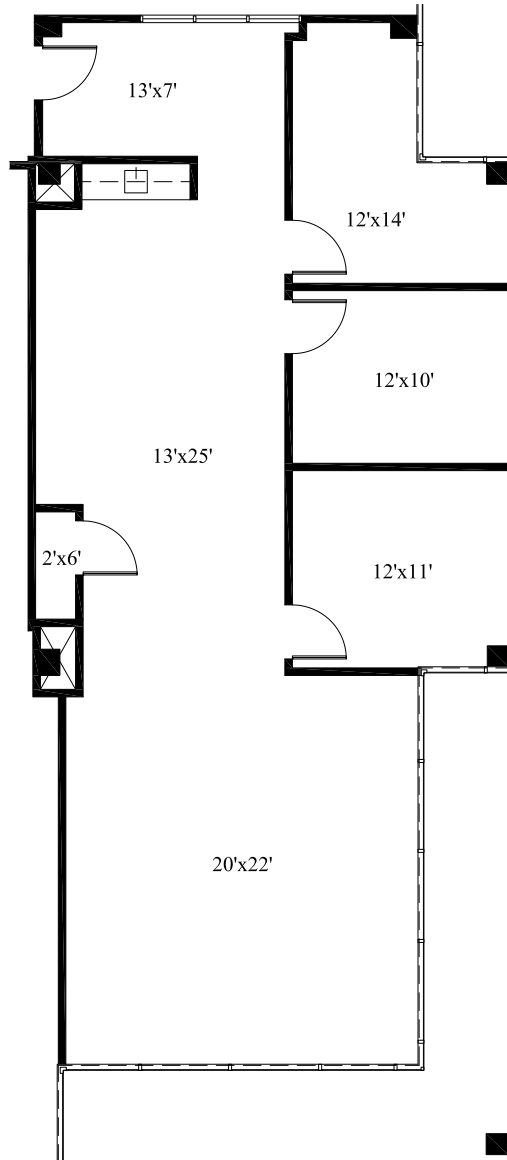

2ND FLOOR

Scale: 3/32"=1'-0"

All dimensions and square footages are approximate.

February 4, 2022



THOMPSON CONSULTING SERVICES, INC.

12024 Golden Meadow Lane, Forney, Texas 75126 (972)564-5252