

LINCOLN SQUARE

LINCOLN SQUARE NORTH

10401 NE 8th
Bellevue, WA 98004



For more information or to
schedule a tour, please contact:

PAUL SWEENEY
425.646.5225
sweeney@broderickgroup.com

JIM KINERK
425.646.5221
kinerk@broderickgroup.com


CLAYTON HOLM
425.274.4287
holm@broderickgroup.com

LINCOLN SQUARE NORTH

Floor 28 • 20,465 RSF • As-Built Plan

SPACE FEATURES

- Available with 120 days notice
- Unobstructed Lake Washington and Seattle Skyline views
- Currently built out for Microsoft's collaborative dining space
- Rare private deck with incredible views
- 20 foot slab to slab

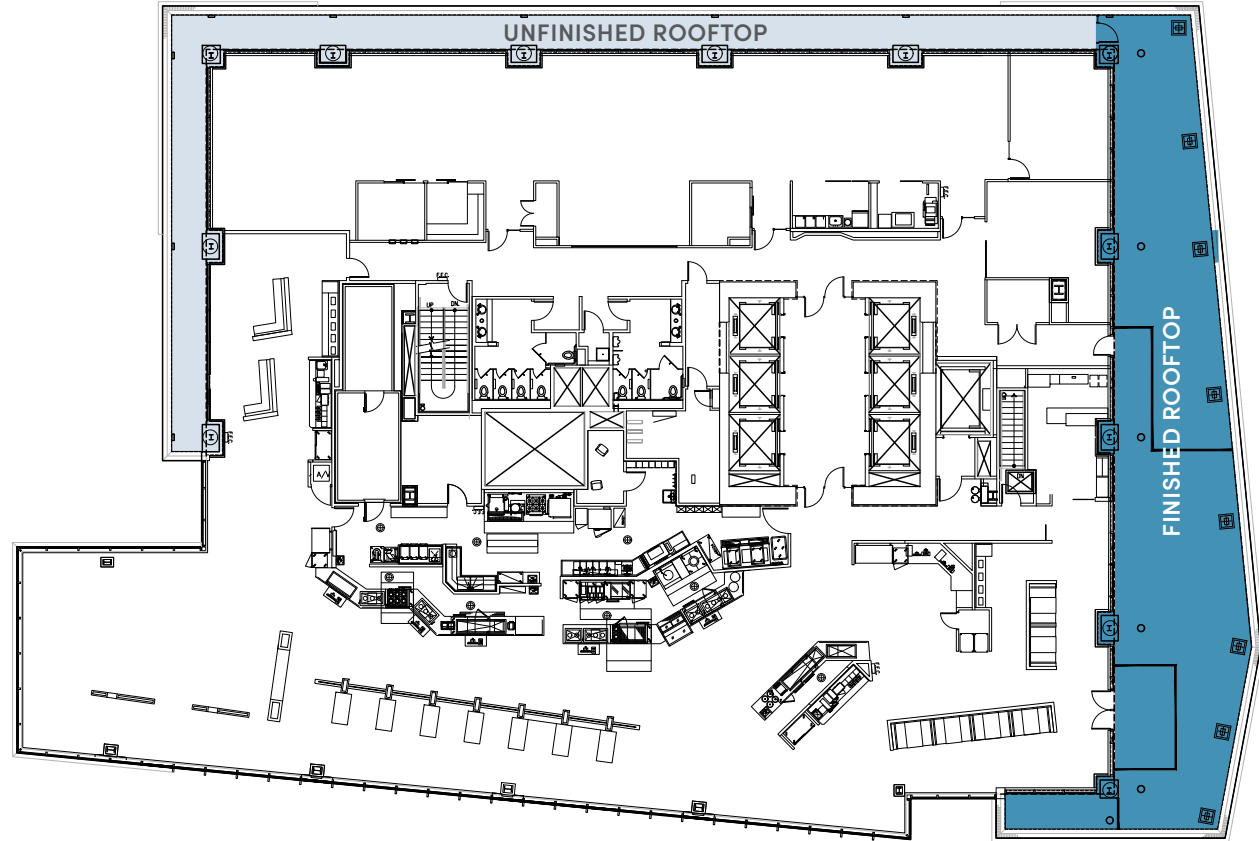

[BACK TO AVAILABILITIES](#)