
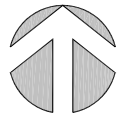


1st Avenue NW

1st Place NW

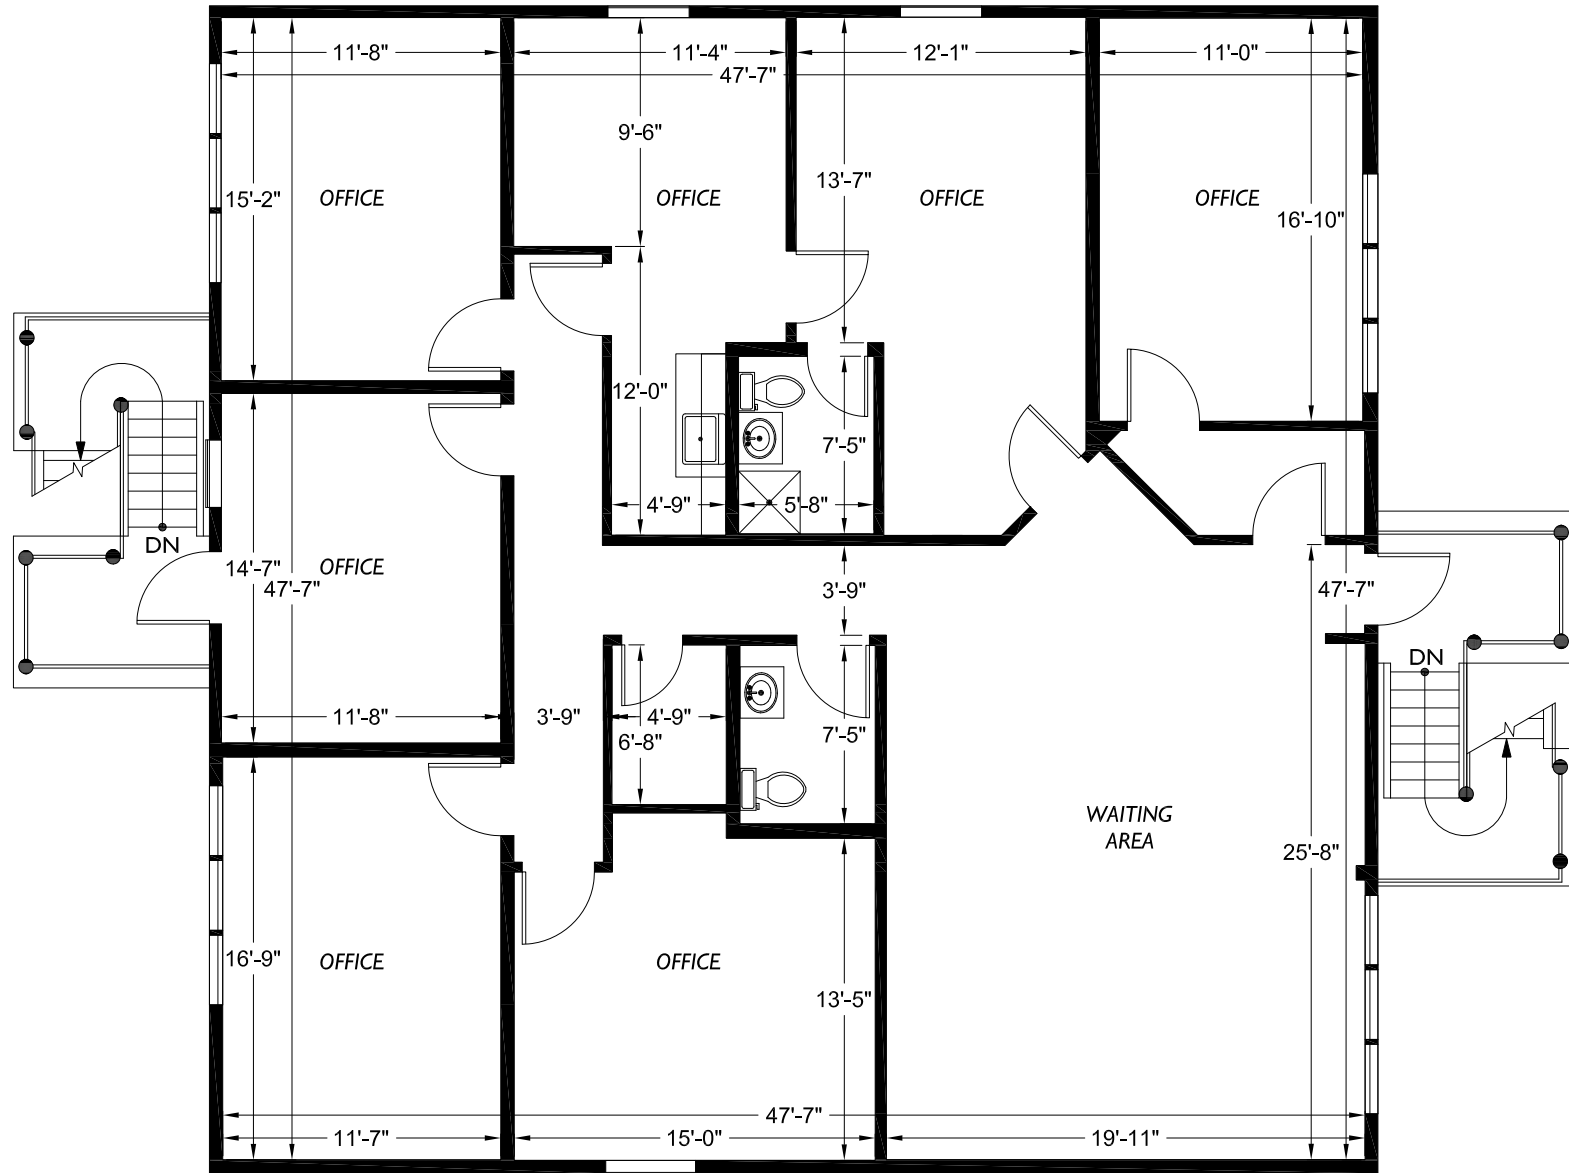

<p>Anuj Bansal 55 1st Place NW Issaquah, WA 98027</p>	<p>Office 55 1st Place NW Issaquah, WA 98027</p>	<p>Floor Plan <b>2</b></p>	<p>0 10 Scale: 1/8" = 1'-0"</p>	<p><b>2-D</b> 2DFLOORPLANS.COM 206-328-7410 AS-BUILT FLOOR PLANS 600 NW Gilman Blvd. Suite E Issaquah, WA 98027</p>
<p><b>Client</b></p>	<p><b>Subject</b></p>	<p><b>Floor</b></p>	<p><b>Scale</b></p>	<p><b>Measured:</b> March 2016     <b>Project:</b> C16-323</p>