


REVISION

DATE  
01.26.06  
DRAWN BY  
TCW

PROJECT  
NUMBER  
689

**WILSON AND WILSON**  
ARCHITECTS  
CONCORD, NEW HAMPSHIRE

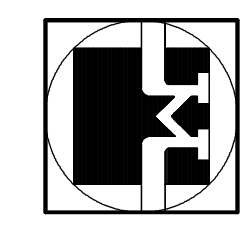

PEABODY MILL - RIVERFRONT PLACE  
ACORN ASSOCIATES XVII LTD  
TILTON, NEW HAMPSHIRE

EXISTING PLANS

© COPY RIGHT 2006: WILSON & WILSON ARCHITECTS  
**OWNE**