

Poskanzer Skott
Architects



550 North Maple Ave
Ridgewood, NJ 07450
Tel 201-445-2322
Fax 201-445-3053
E-mail poskott@psola.com

building:
OFFICE CENTER AT RAMSEY
500 N. FRANKLIN TRKE - FIRST FLOOR
RAMSEY, NJ 07446

drawing title:
SUITE 102 - 1800 +/- RSF
AS-BUILT


drawing number:

102

file: 0744-102.dwg

date: 01/15/04

scale: 1/8" = 1'-0"

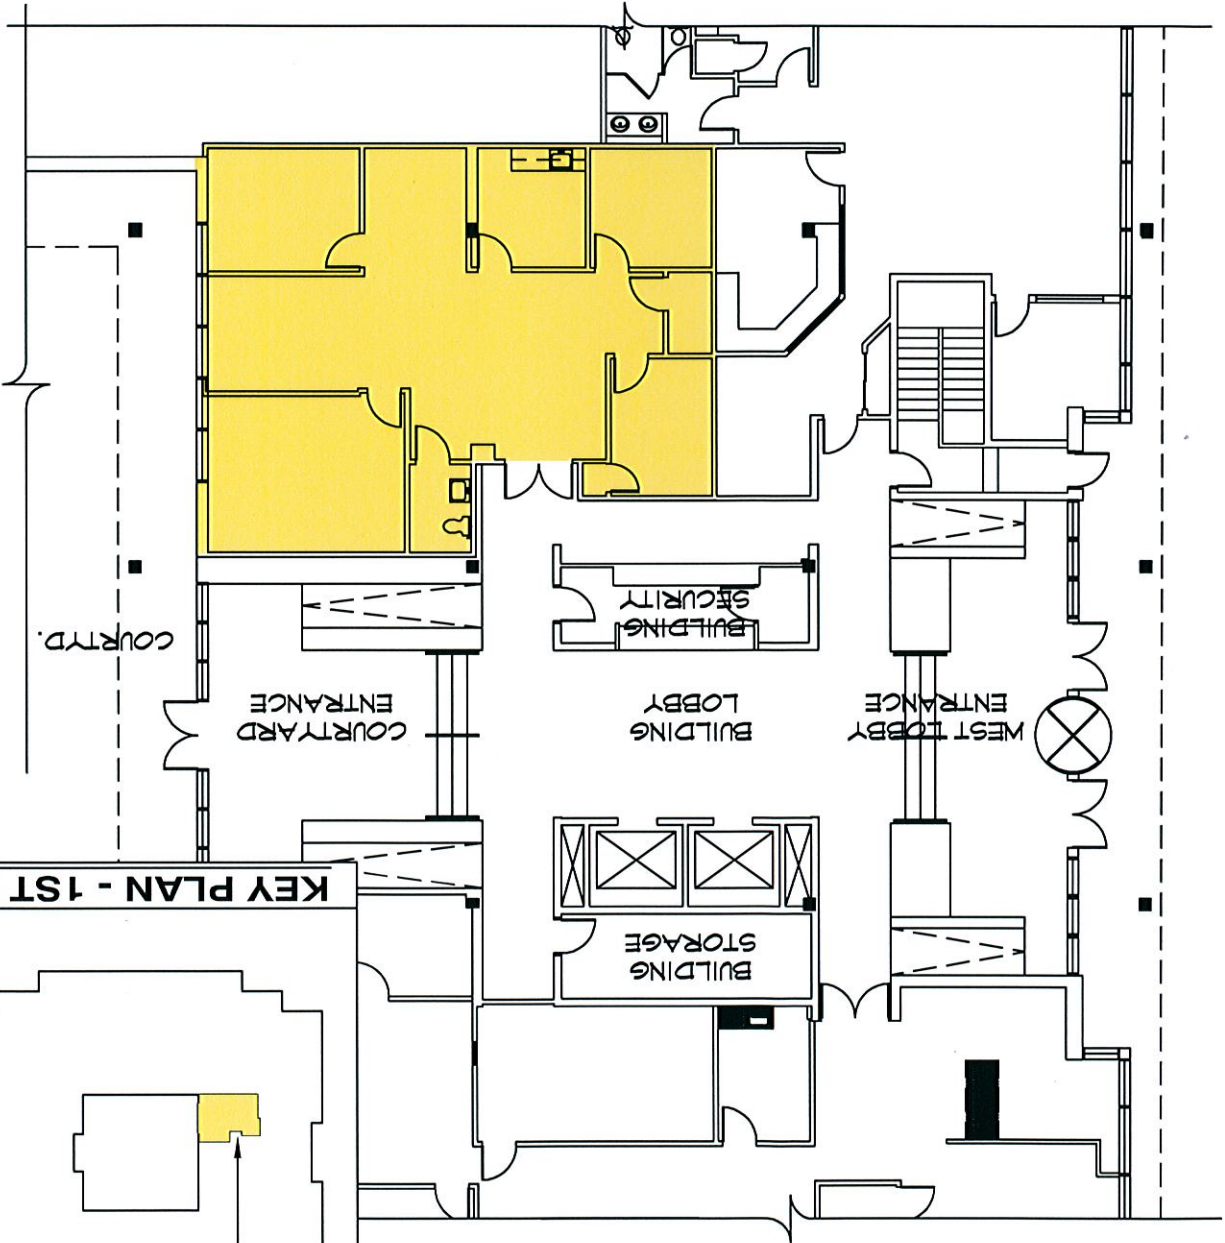

KEY PLAN - 1ST FL.

