



NORTHUP BUILDING

FOR MORE INFO  
PLEASE CONTACT

**TOM BOHMAN**

Senior Vice President  
+1 425 462 6911  
tom.bohman@cbre.com

**LENNON ATTEBERRY**

First Vice President  
+1 425 462 6991  
lennon.attedberry@cbre.com

**CBRE, INC.**


929 108th Avenue NE  
Suite 700  
Bellevue, WA 98004

**CBRE**

# SUITE 300

AS-BUILT FLOOR PLAN |  $\pm 7,075$  RSF

MARKET READY SUITE

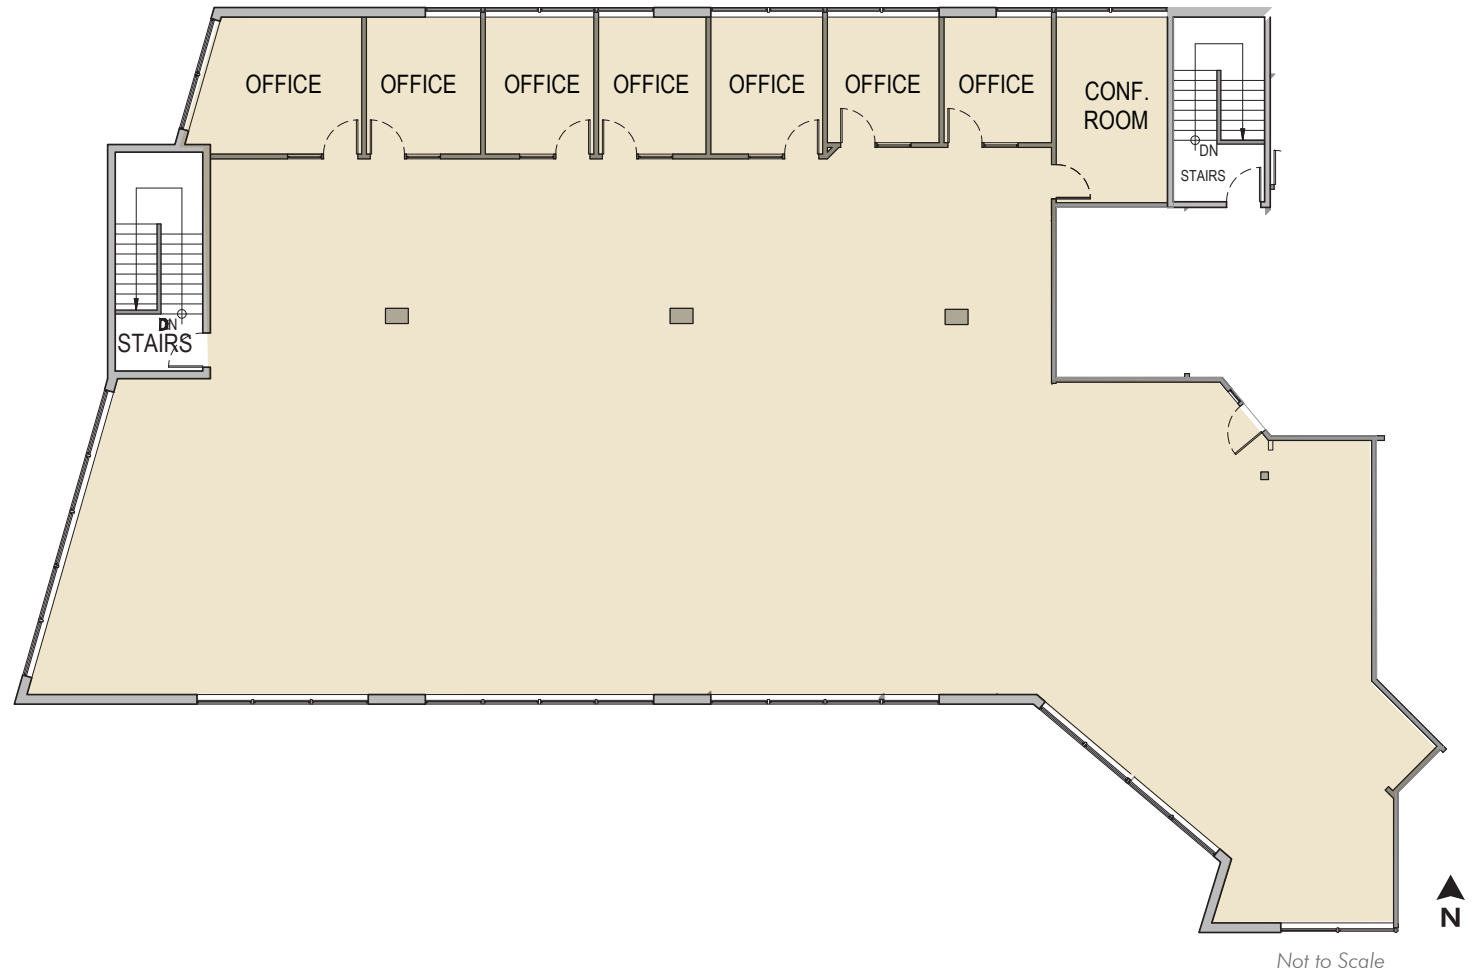

© 2021 CBRE, Inc. All rights reserved. This information has been obtained from sources believed reliable, but has not been verified for accuracy or completeness. You should conduct a careful, independent investigation of the property and verify all information. Any reliance on this information is solely at your own risk. CBRE and the CBRE logo are service marks of CBRE, Inc. Photos herein are the property of their respective owners and use of these images without the express written consent of the owner is prohibited. ar3.2.21



NORTHUP BUILDING

FOR MORE INFO  
PLEASE CONTACT

**TOM BOHMAN**

Senior Vice President  
+1 425 462 6911  
tom.bohman@cbre.com

**LENNON ATTEBERRY**

First Vice President  
+1 425 462 6991  
lennon.attedberry@cbre.com

**CBRE, INC.**

929 108th Avenue NE  
Suite 700  
Bellevue, WA 98004

**CBRE**

# SUITE 300

## CONCEPTUAL FLOOR PLAN | ±7,075 RSF



Not to Scale

© 2021 CBRE, Inc. All rights reserved. This information has been obtained from sources believed reliable, but has not been verified for accuracy or completeness. You should conduct a careful, independent investigation of the property and verify all information. Any reliance on this information is solely at your own risk. CBRE and the CBRE logo are service marks of CBRE, Inc. Photos herein are the property of their respective owners and use of these images without the express written consent of the owner is prohibited. ar3.2.21