

**EXISTING GROUND LEVEL  
FLOOR PLAN**


**NOTES:**  
 \* ALL DIMENSIONS TO BE FIELD VERIFIED BY ARCHITECT.  
 \* GENERAL CONTRACTOR SHALL VERIFY ALL DIMENSIONS AND CONDITIONS IN FIELD.  
 \* ROOF PITCH TO BE VERIFIED IN FIELD.  
 \* ALL FLOORS ARE NOTED.  
 \* WALL CONSTRUCTION TO BE VERIFIED IN FIELD.

EXISTING SQUARE FOOTAGE: 13514 sq ft  
 H/VAC: \_\_\_\_\_

SHEET #  <h1 style="font-size: 2em; margin: 0;">2</h1>  2 OF 3	 <b>FINE IMPRESSIONS STUDIOS</b> ARCHITECTURAL DRAFTING & DESIGN 920 59th Street West Bradenton, FL 34205 941.748.0613	<b>TITLE:</b> <h2 style="font-size: 1.5em; margin: 0;">Existing Floor Plan</h2> 6500 Manatee Avenue West Bradenton, Florida 34209	<b>CLIENT:</b>  AS-BUILT DATE: <b>04/14/12</b>  REVISIONS:	<b>FINAL DRAFT:</b>  REVISIONS:	<b>SCALE:</b> <b>1/8" = 1'</b>  <b>DRAFTED BY:</b> <b>J.M.W.</b>  <b>DESIGNED BY:</b>
--	--	--	---	---------------------------------------	---

TO THE BEST OF THE DESIGNER'S KNOWLEDGE, THE DESIGN REPRESENTED BY THESE DRAWINGS CONTAINS ALL PERTINENT INFORMATION AS REQUESTED BY THE CLIENT AND FOUND EXISTING ON SITE.

ALL RIGHTS RESERVED. REPRODUCTION OF ANY PORTION OF THESE PLANS IS PROHIBITED. THESE DRAWINGS ARE PREPARED AND SOLD FOR USE IN CONNECTION WITH THE CONSTRUCTION OF ONE BUILDING ONLY. NO PART OF THESE PLANS IS TO BE REPRODUCED OR TRANSMITTED IN ANY FORM OR BY ANY MEANS, ELECTRONIC OR MECHANICAL, WITHOUT THE WRITTEN APPROVAL OF THE DESIGNER. THESE DRAWINGS REMAIN THE PROPERTY OF THE DESIGNER.

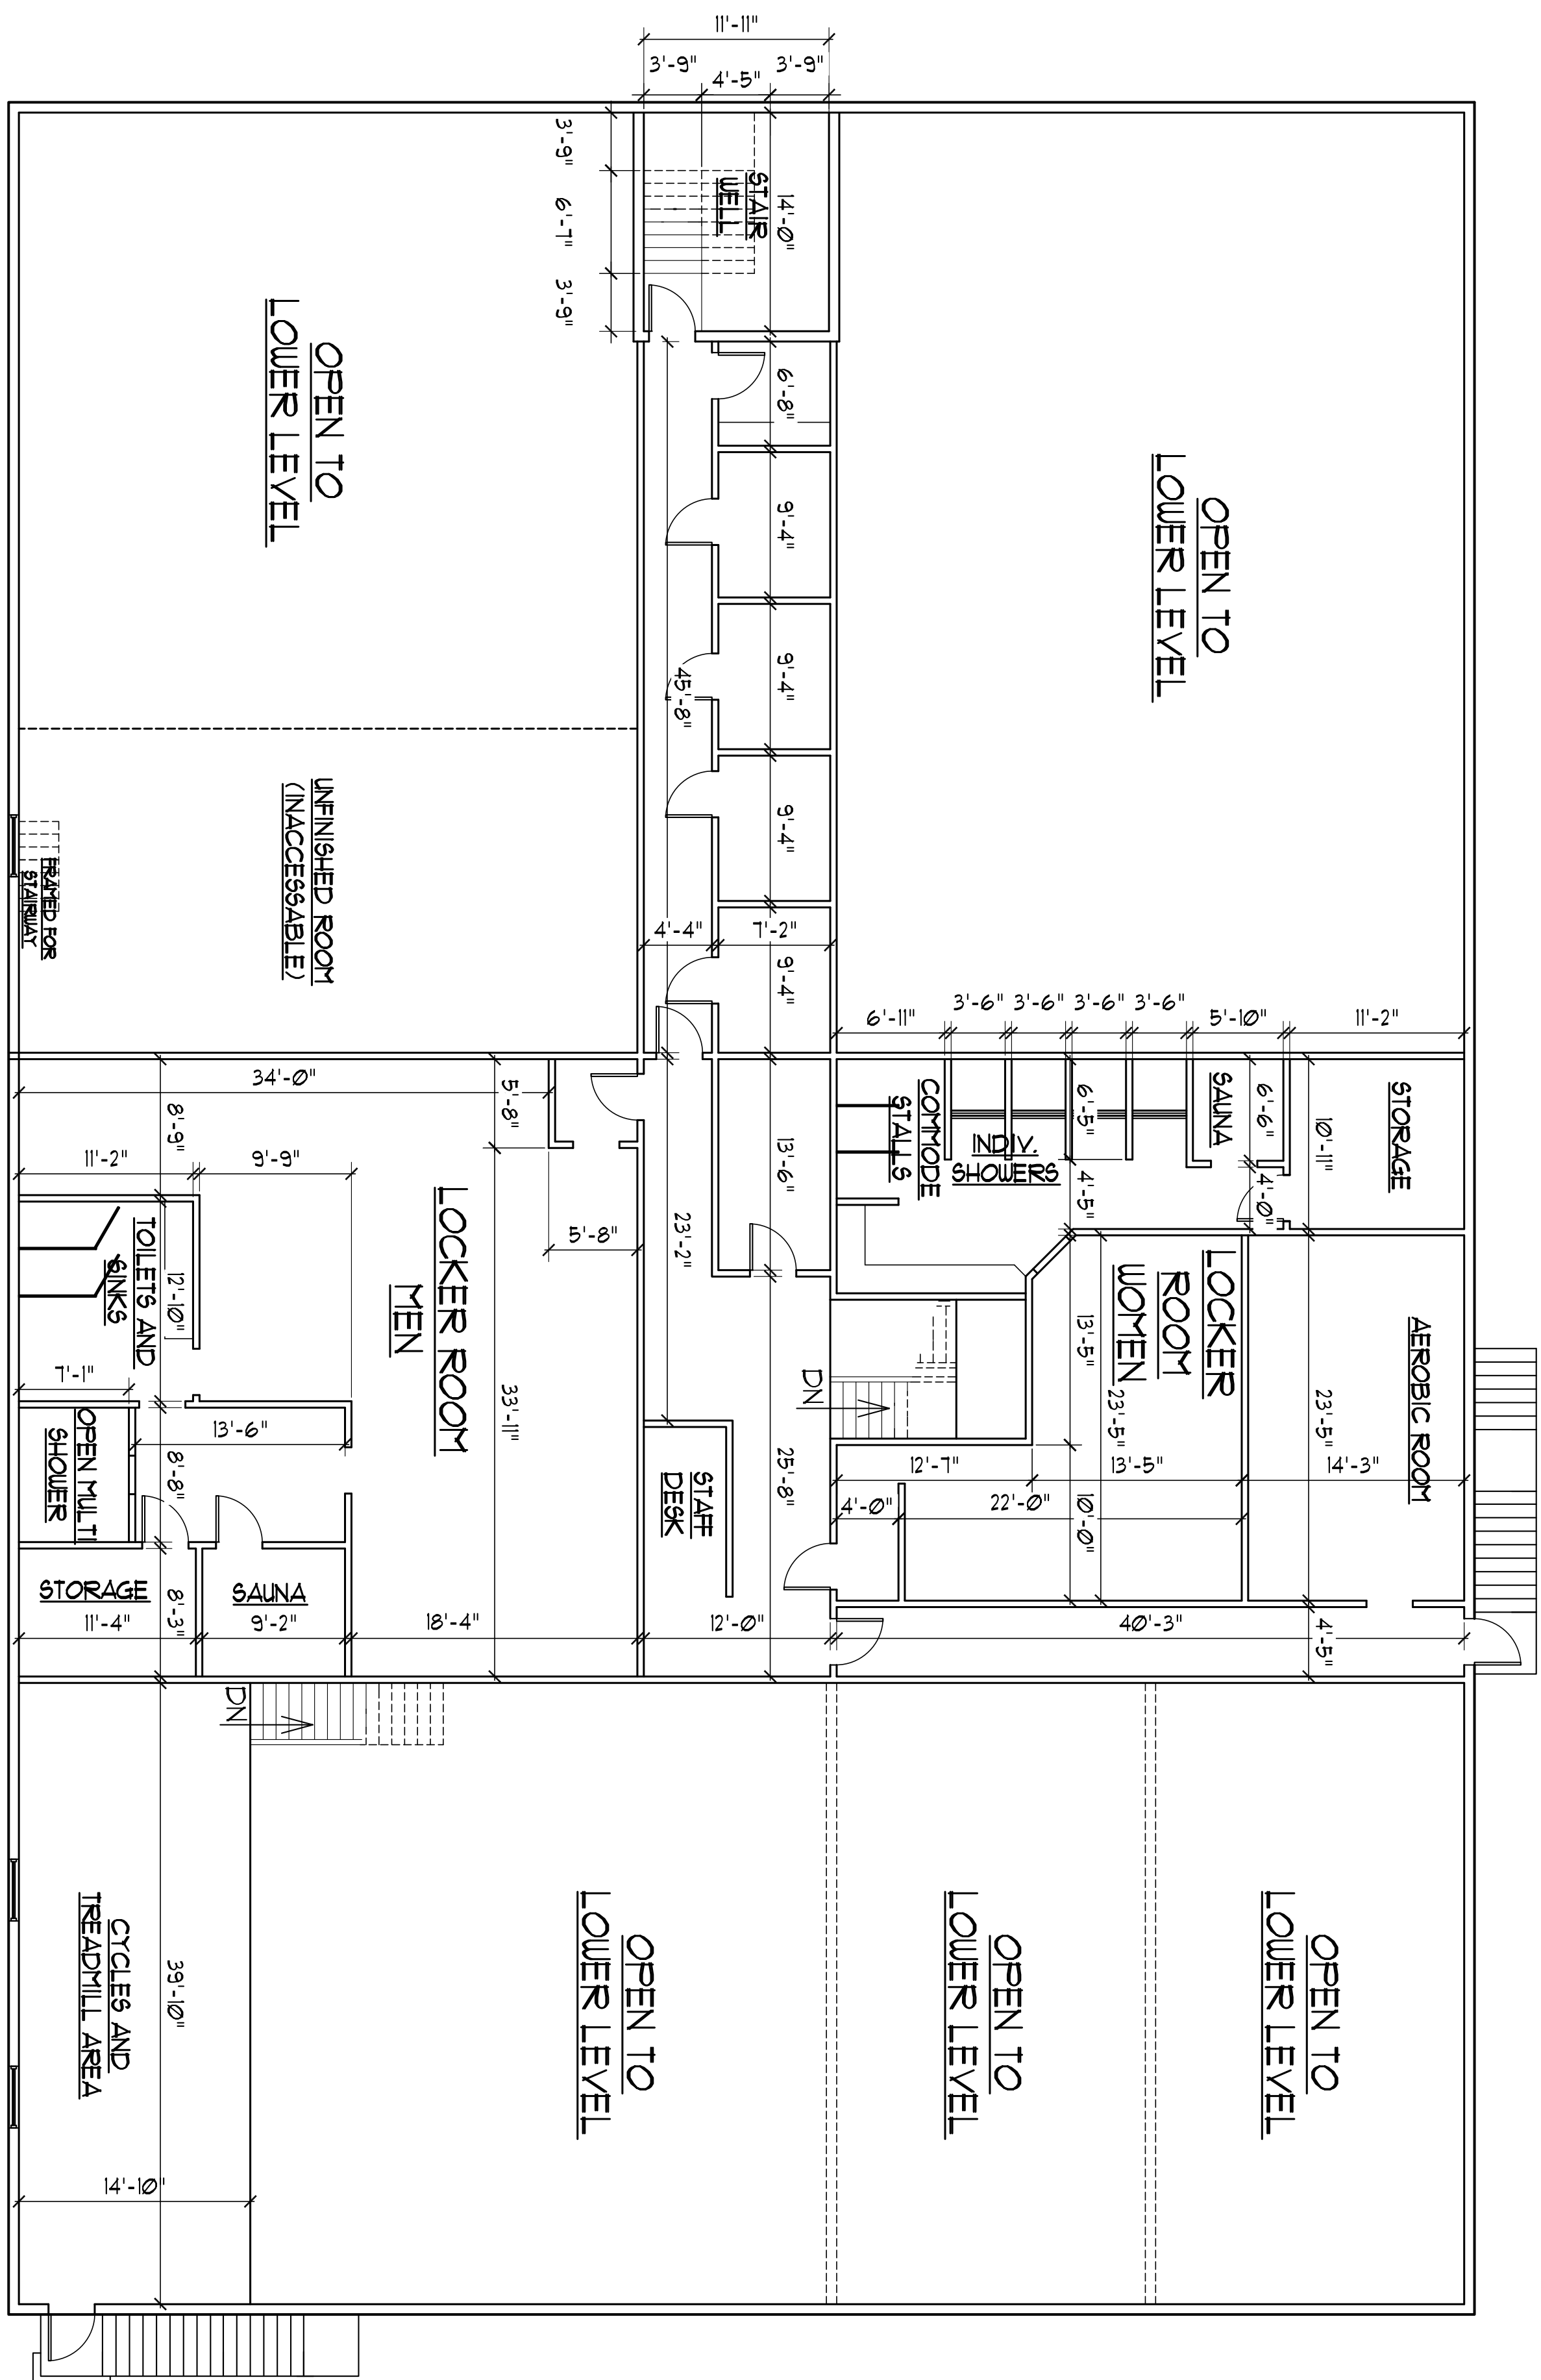

EXISTING FLOOR PLAN

EXISTING SQUARE FOOTAGE: 4,475 sq ft

SHEET # **3** OF 3

**FINE IMPRESSIONS STUDIOS**  
 ARCHITECTURAL DRAFTING & DESIGN  
 920 59th Street West  
 Bradenton, FL 34205  
 941.748.0613

TITLE: **Existing Floor Plan**  
 6500 Manatee Avenue West  
 Bradenton, Florida 34209

CLIENT:			
AS-BUILT DATE: <b>04/14/12</b>	FINAL DRAFT:	SCALE: <b>1/8" = 1'</b>	
REVISIONS:	REVISIONS:	DRAFTED BY: <b>J.M.W.</b>	DESIGNED BY:

TO THE BEST OF THE DESIGNER'S KNOWLEDGE, THE DESIGN REPRESENTED BY THESE DRAWINGS CONTAINS ALL PERTINENT INFORMATION AS REQUESTED BY THE CLIENT AND FOUND EXISTING ON SITE.  
 ALL RIGHTS RESERVED. REPRODUCTION OF ANY PORTION OF THESE PLANS IS PROHIBITED. THESE DRAWINGS ARE PREPARED AND SOLD FOR USE IN CONSTRUCTION OF ONE BUILDING ONLY. NO PERMITTED VENDOR IS PERMITTED TO MAKE ANY CHANGES TO THE ORIGINAL OF THESE DRAWINGS WITHOUT THE WRITTEN APPROVAL OF THE DESIGNER. THESE DRAWINGS REMAIN THE PROPERTY OF THE DESIGNER.