
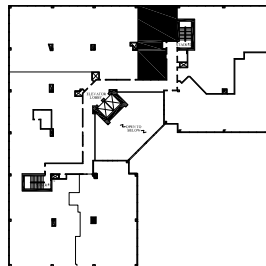


HIGHPOINT MEDICAL BUILDING

800 West Arbrook Boulevard, Arlington, Texas

SUITE 335
1,017 RSF

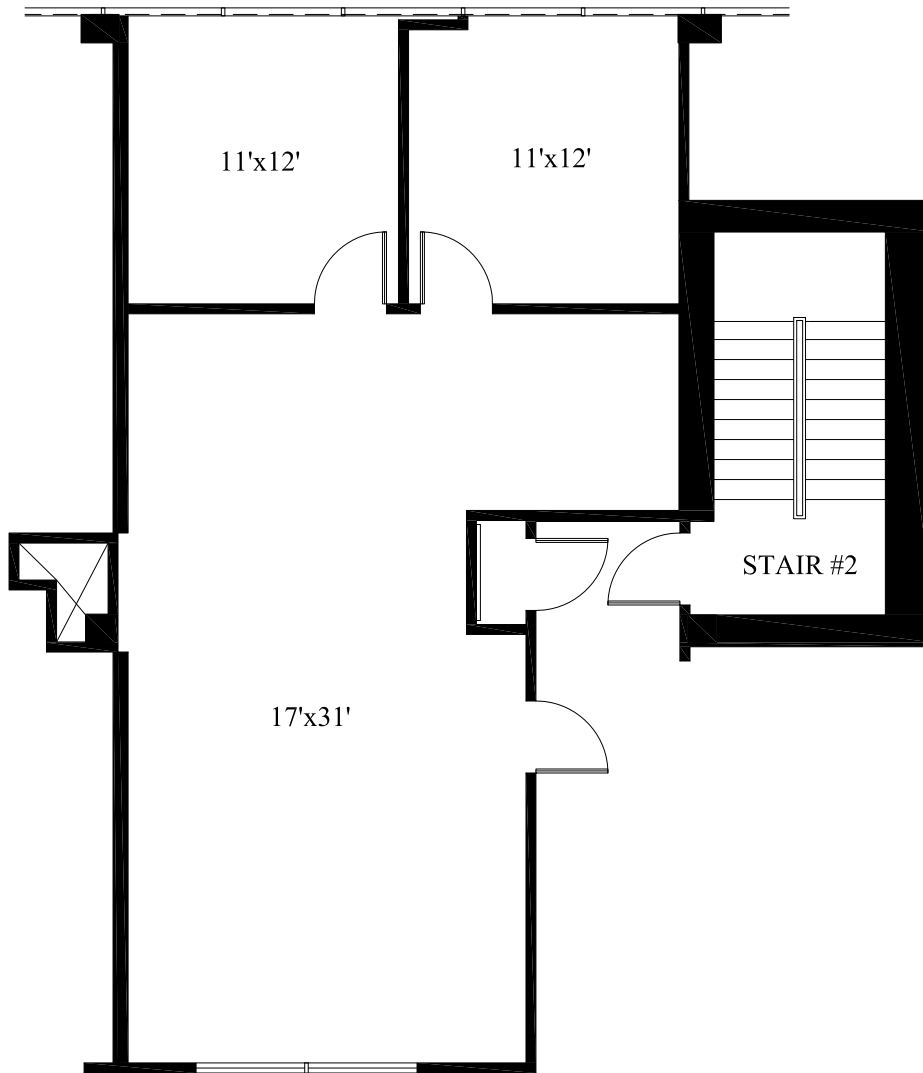

3RD FLOOR

Scale: 1/8"=1'-0"

All dimensions and square footages are approximate.

February 4, 2022

