


SUITE 207  
521 RSF

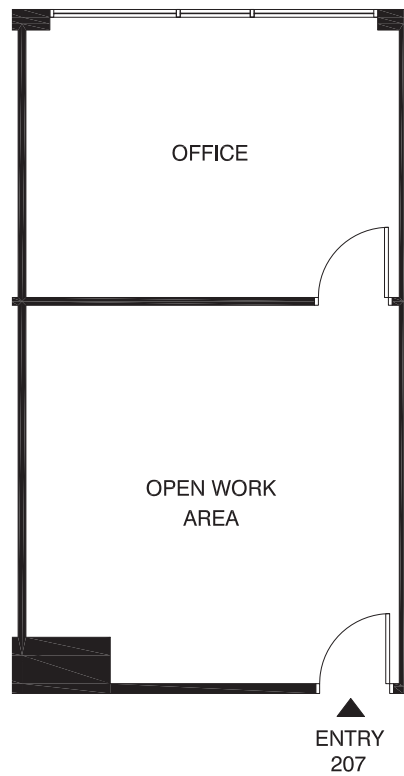

**KEARNY OFFICE PARK**  
8316 Clairemont Mesa Blvd.  
SUITE 207  
AS-BUILT PLAN (SCALE: 1/8"=1'-0")