

RIDGEWOOD


CORPORATE SQUARE
a **KBS** property

BUILDING A

Suite 201: 1,972 RSF

As-Built Plan

Available: Now

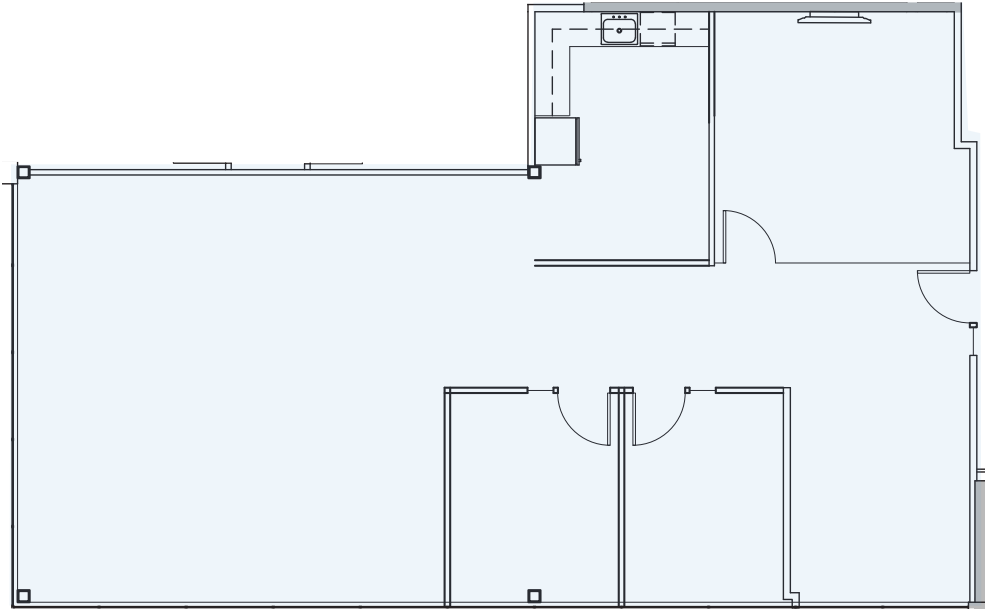

FOR MORE INFORMATION

Scott Davis

425.462.6912
scott.davis@cbre.com

Cortney Schirman

425.462.6975
cortney.schirman@cbre.com

Proudly leased
and managed by

