



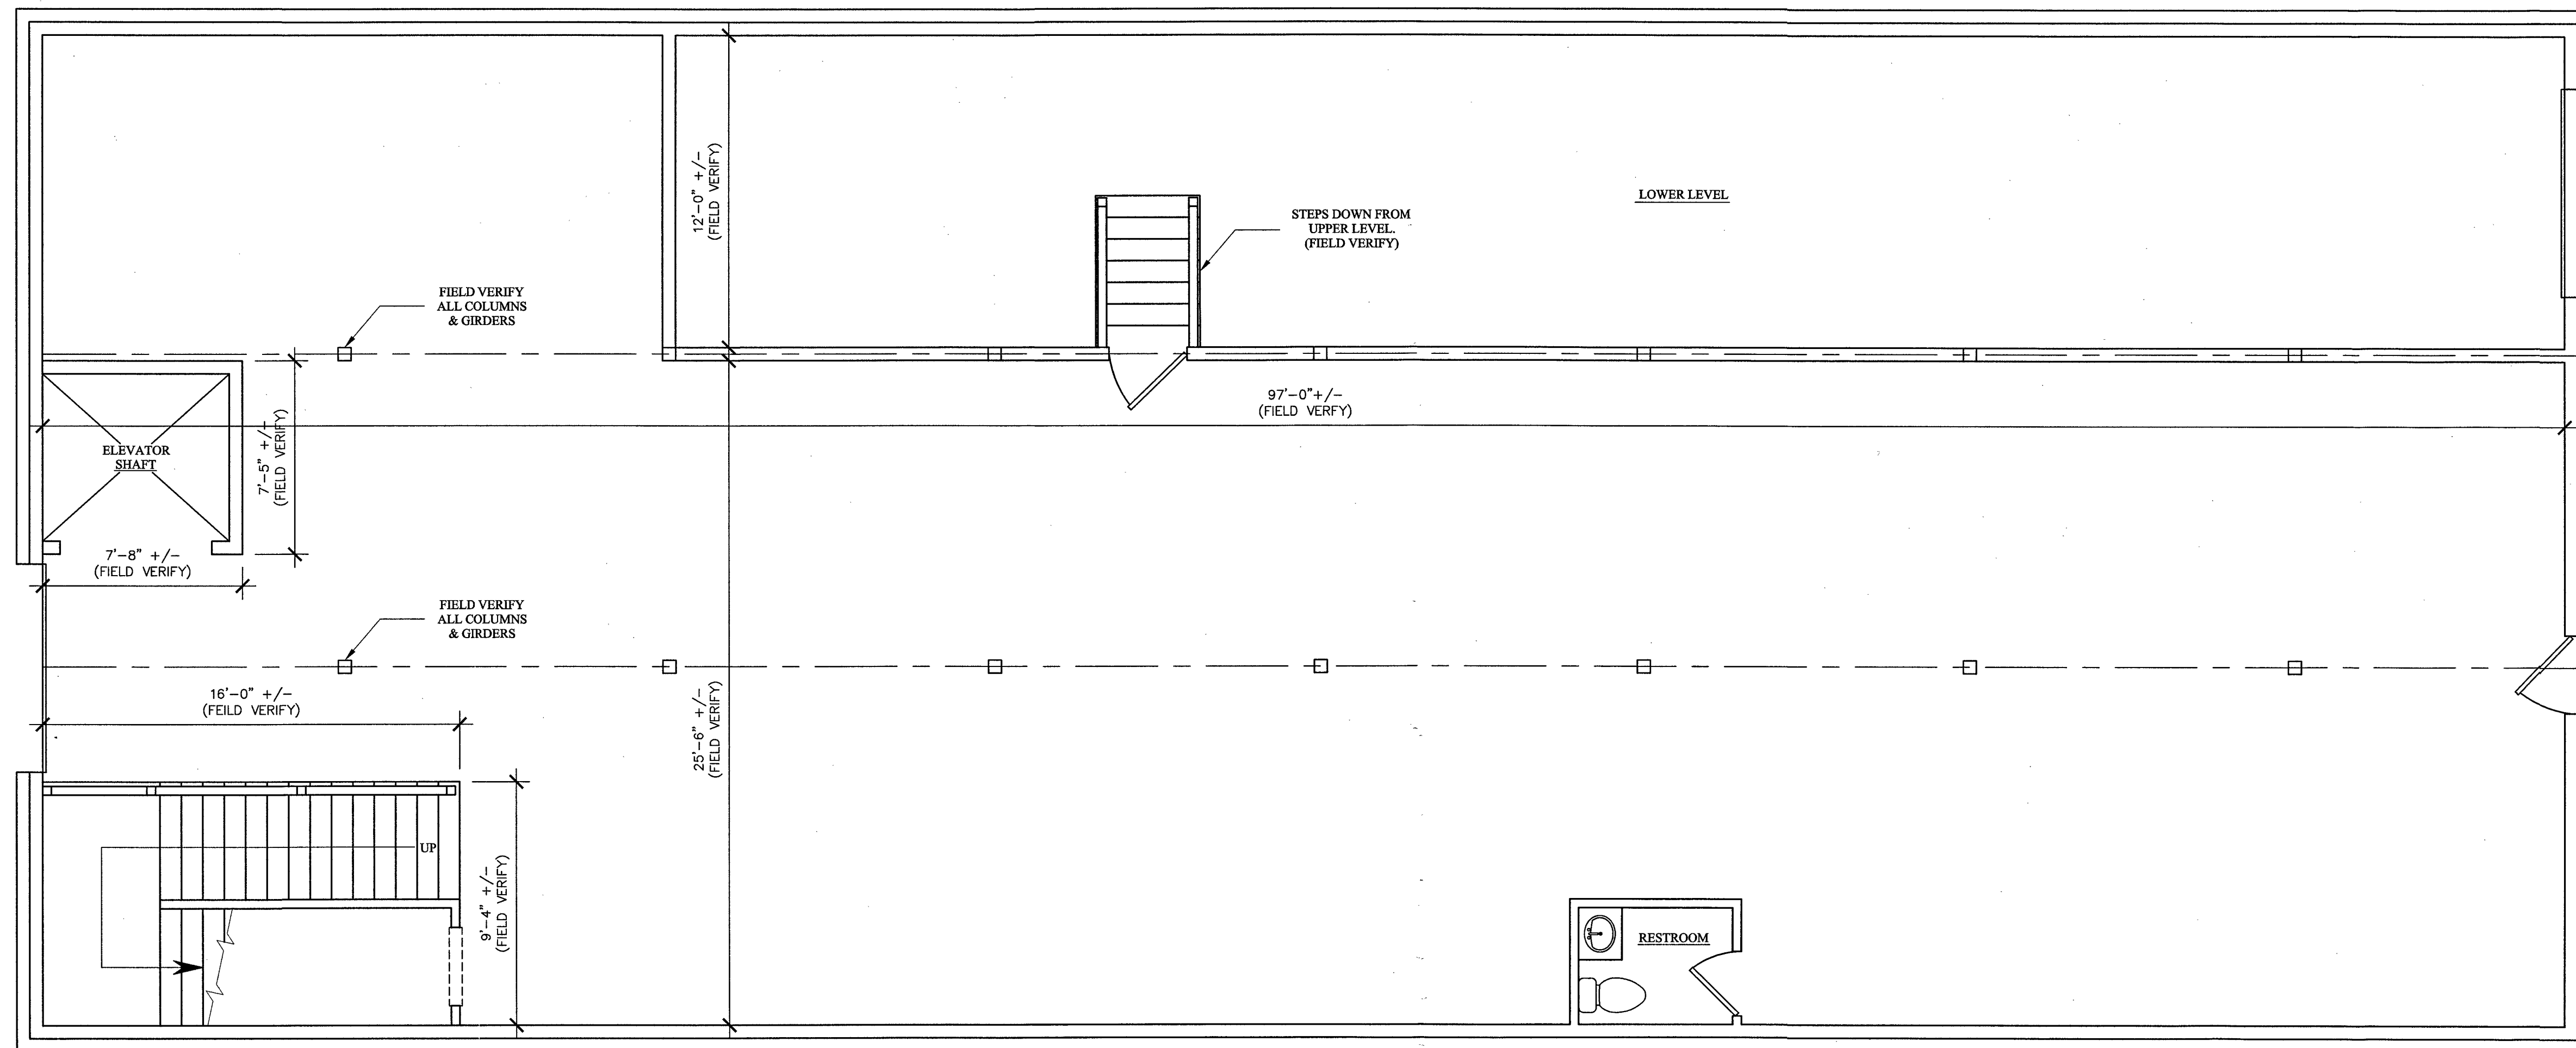

1
B1 FIRST FLOOR PLAN
1/4"=1'-0"

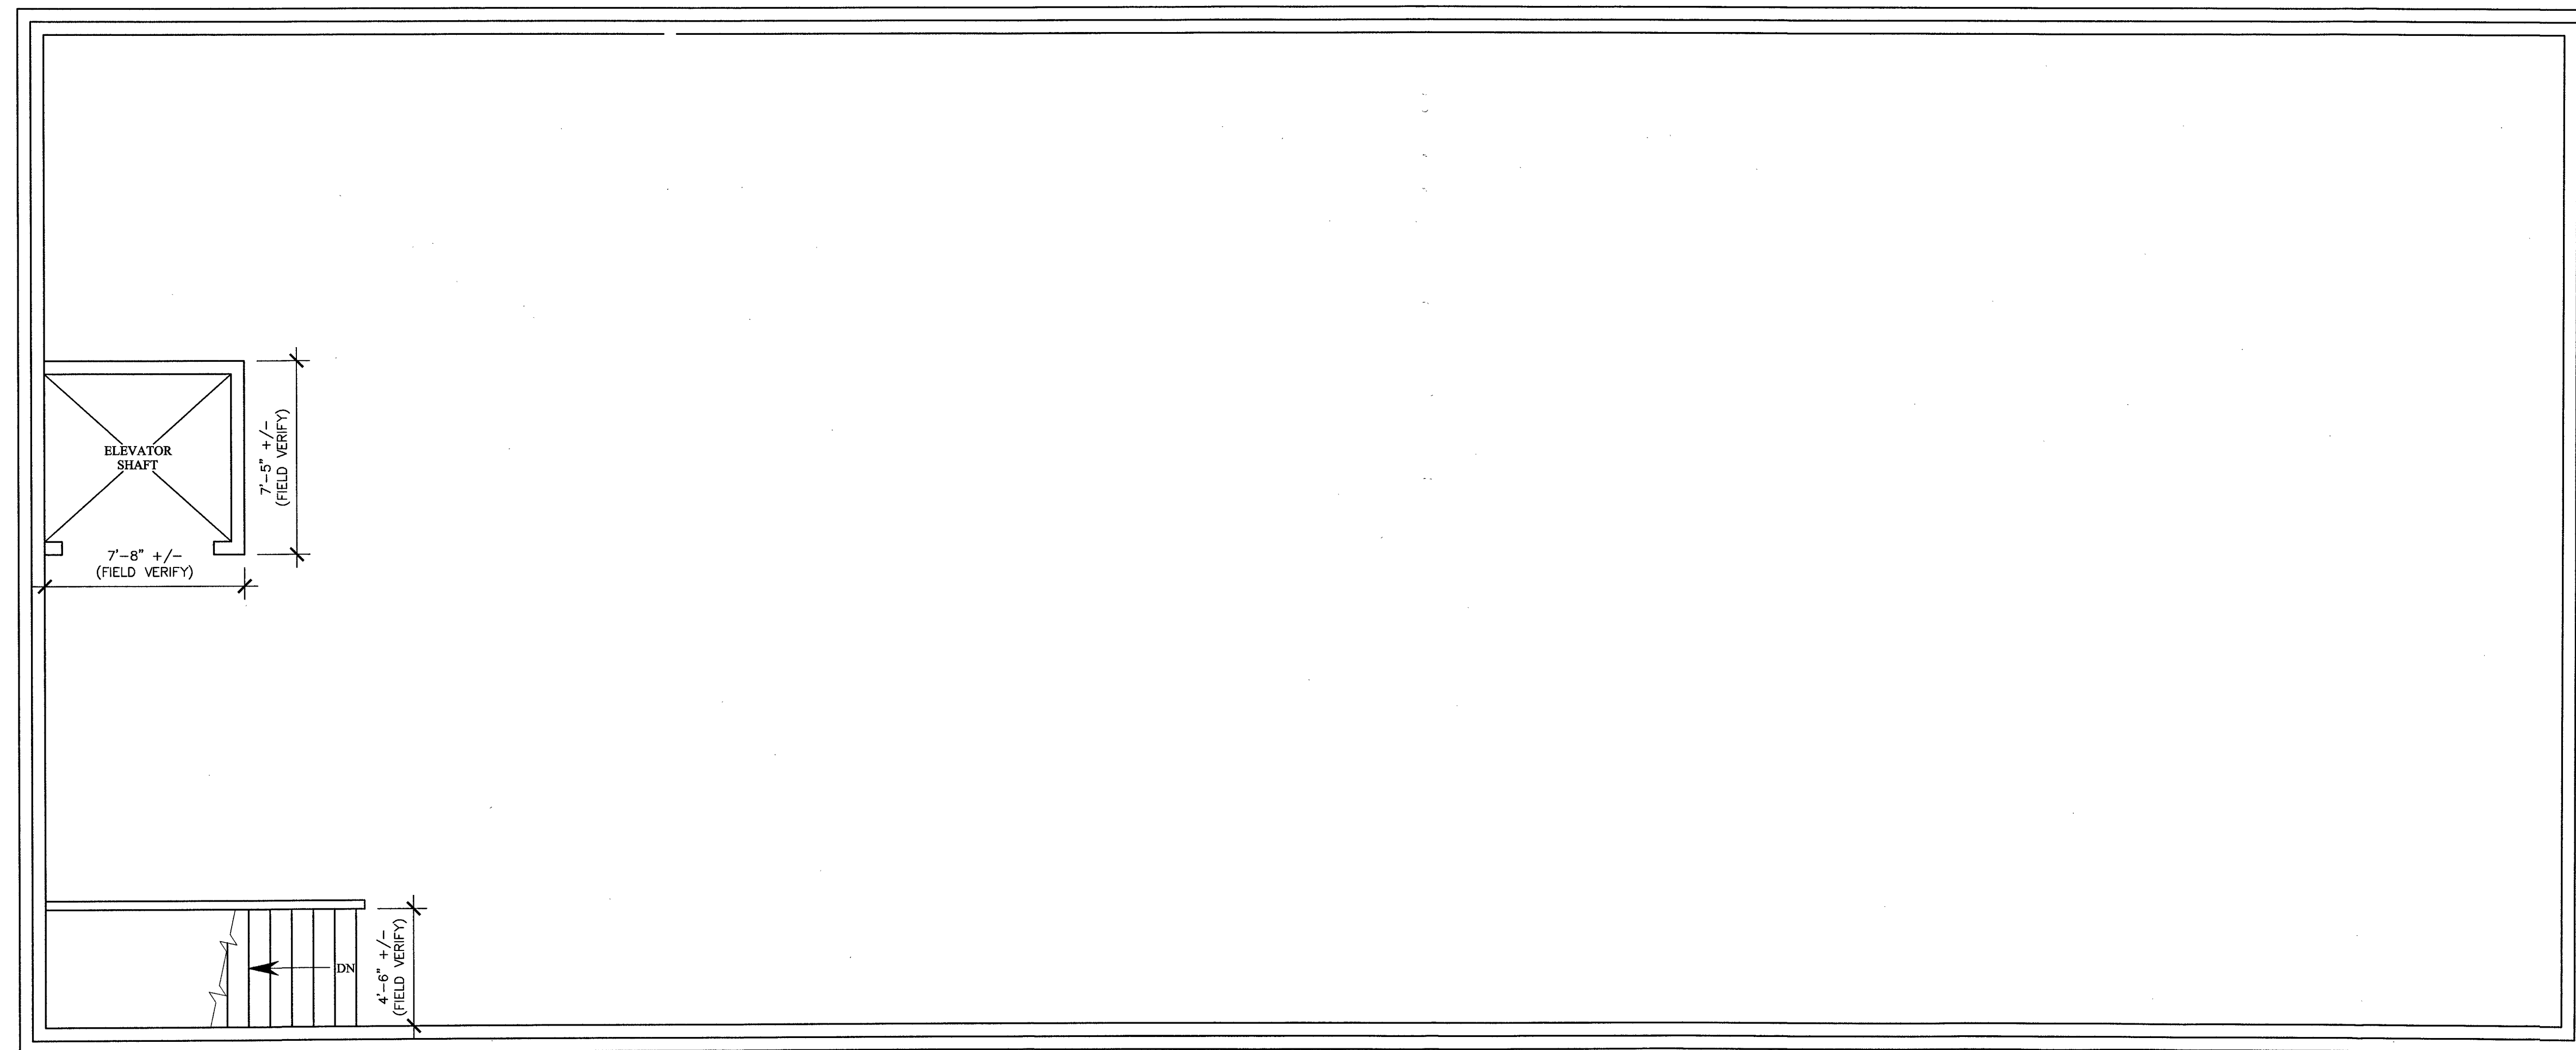


1
B1 SECOND FLOOR PLAN
1/4"=1'-0"

Mark	Date	Revision/Issue
△		

PLANS FOR:
Horace Tripp
4100 SW Ave.
Ayden, North Carolina

Engineer Stamp

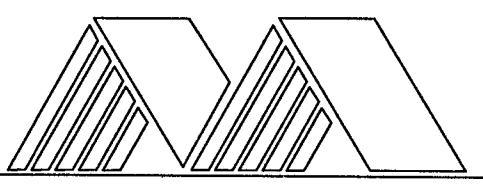

MOSLEY
DESIGN GROUP

N.C.B.E.E.S. LICENSE: P-0185

This drawing and the design shown are the property of Mosley Design Group. Reproduction or use of this drawing without written permission is prohibited.



MOSLEY
DESIGN GROUP

Mosley Design Group
Jeff Mosley, Professional Engineer
1649 B East Arlington, PO Box 8598
Greenville, NC 27835
Voice: 252.321.7744 Fax: 252.321.1020

Date	06-02-16	Sheet
Scale	AS NOTED	B1
Job No.		
Drawn by	P. Cartwright	
Checked		
Approved		