


SUITE 200 - AS BUILT (by BV 11/6/20)

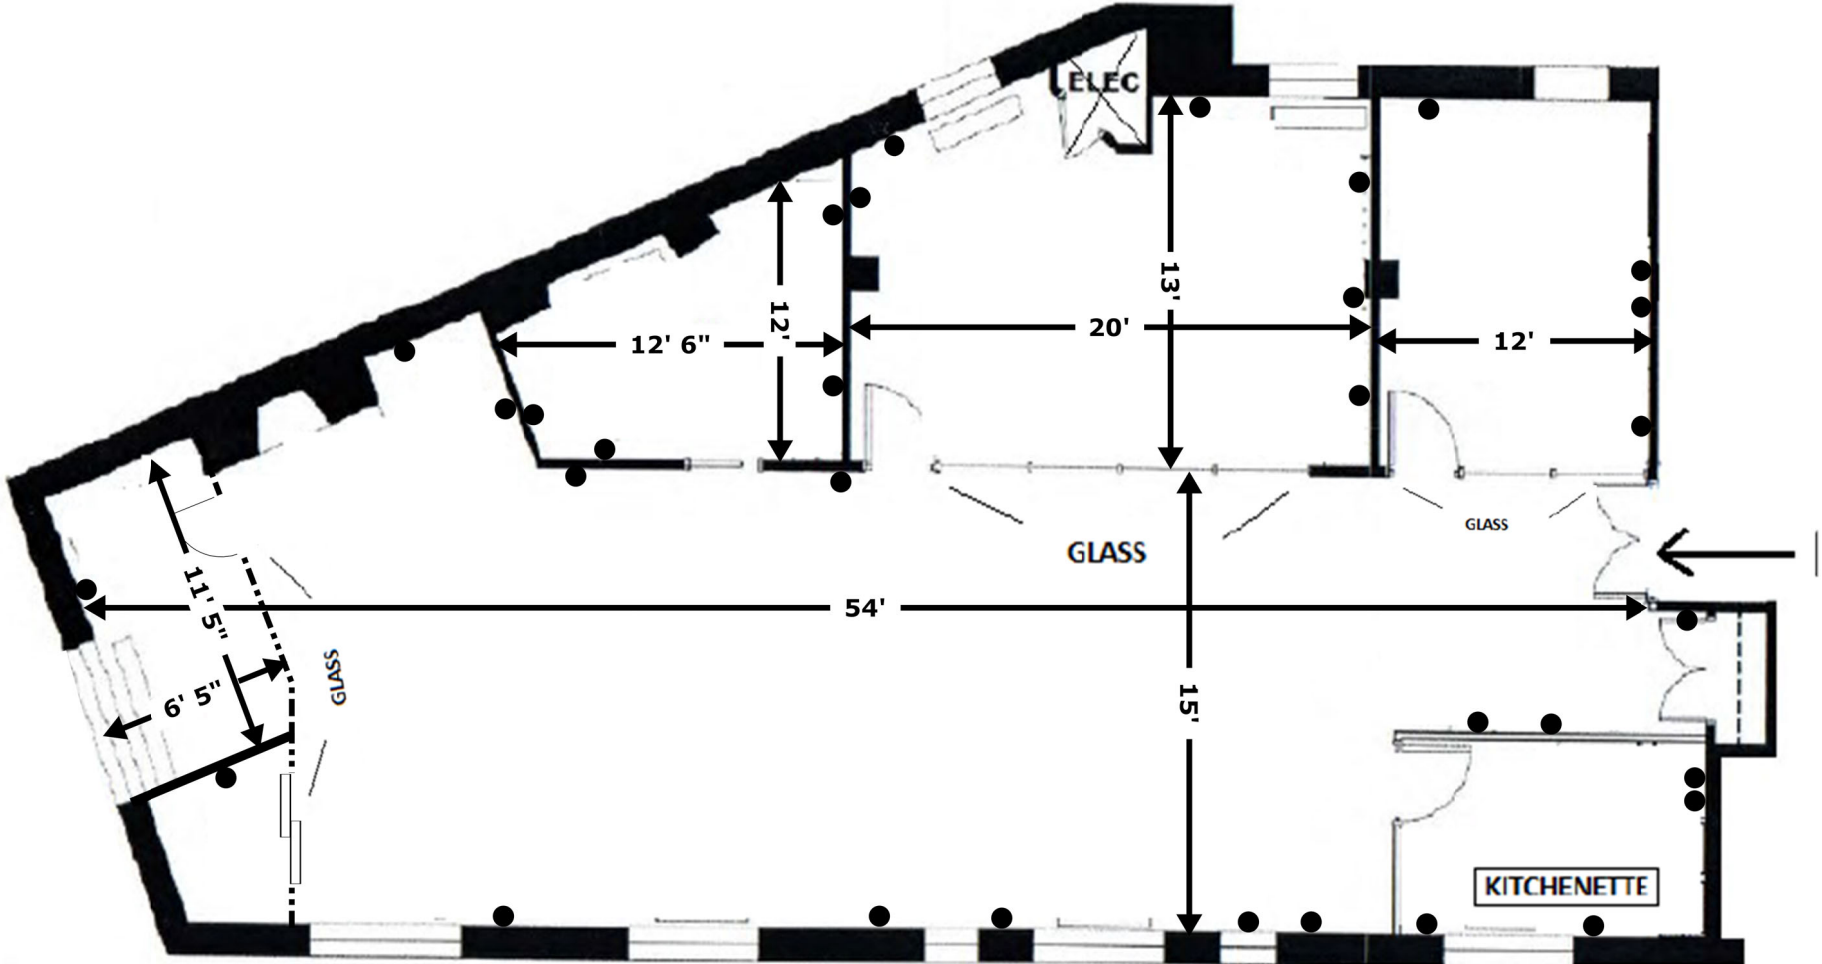

● = ELECTRICAL OUTLET

CEILING HEIGHT = 10' 2" aff