


KENYON CENTER

3326 160th Avenue SE • Bellevue, Washington

Class "A" I-90
Office Space

AVAILABLE FOR LEASE

4TH FLOOR: AS-BUILT PLAN

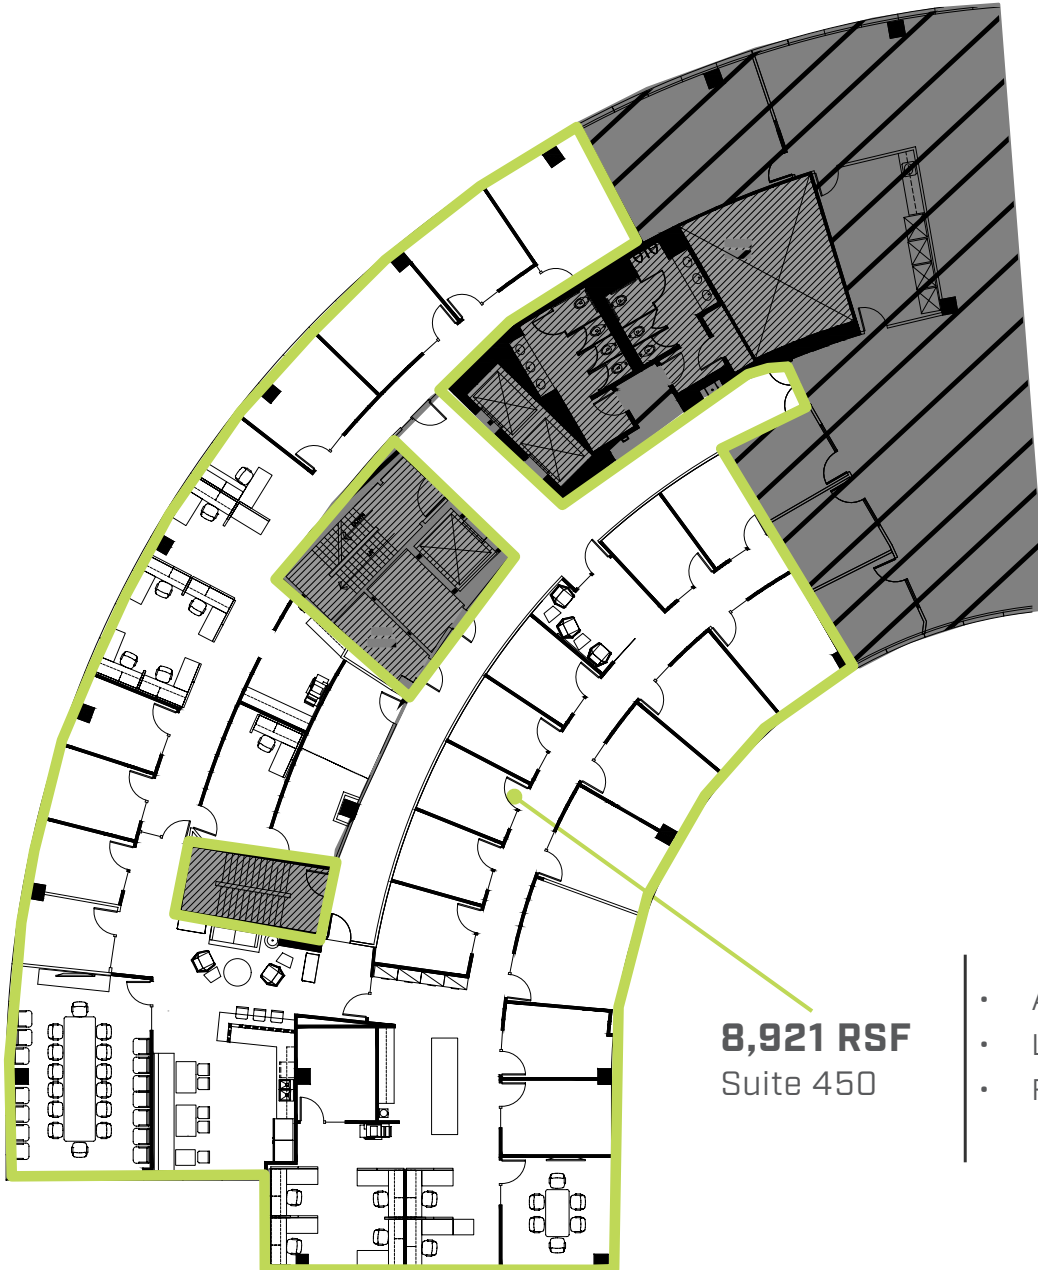

8,921 RSF
Suite 450

- Available Q1 2020
- Lease expires 3/31/2021
- Furniture available



Commercial Real Estate Services

10500 NE 8th Street, Suite 900
Bellevue, Washington 98004
main | 425.646.3444
www.broderickgroup.com

For more information or to schedule a tour, please contact:

JEFF WATSON
425.646.5224

watson@broderickgroup.com

PAUL JERUE
425.646.5223

jerue@broderickgroup.com

The information contained herein has been given to us by the owner or sources that we deem reliable. We have no reason to doubt its accuracy, but we do not guarantee it. Prospective tenants should carefully verify all information contained herein.