

LINCOLN SQUARE

LINCOLN SQUARE NORTH

10401 NE 8th

Bellevue, WA 98004



For more information or to schedule a tour, please contact:

PAUL SWEENEY

425.646.5225

sweeney@broderickgroup.com

JIM KINERK

425.646.5221

kinerk@broderickgroup.com

CLAYTON HOLM

425.274.4287


holm@broderickgroup.com

LINCOLN SQUARE NORTH

Floor 18 • 22,346 RSF • As-Built Plan

SPACE FEATURES

- Available with 120 days notice
- Unobstructed Lake Washington and Seattle Skyline views
- Former Microsoft floor

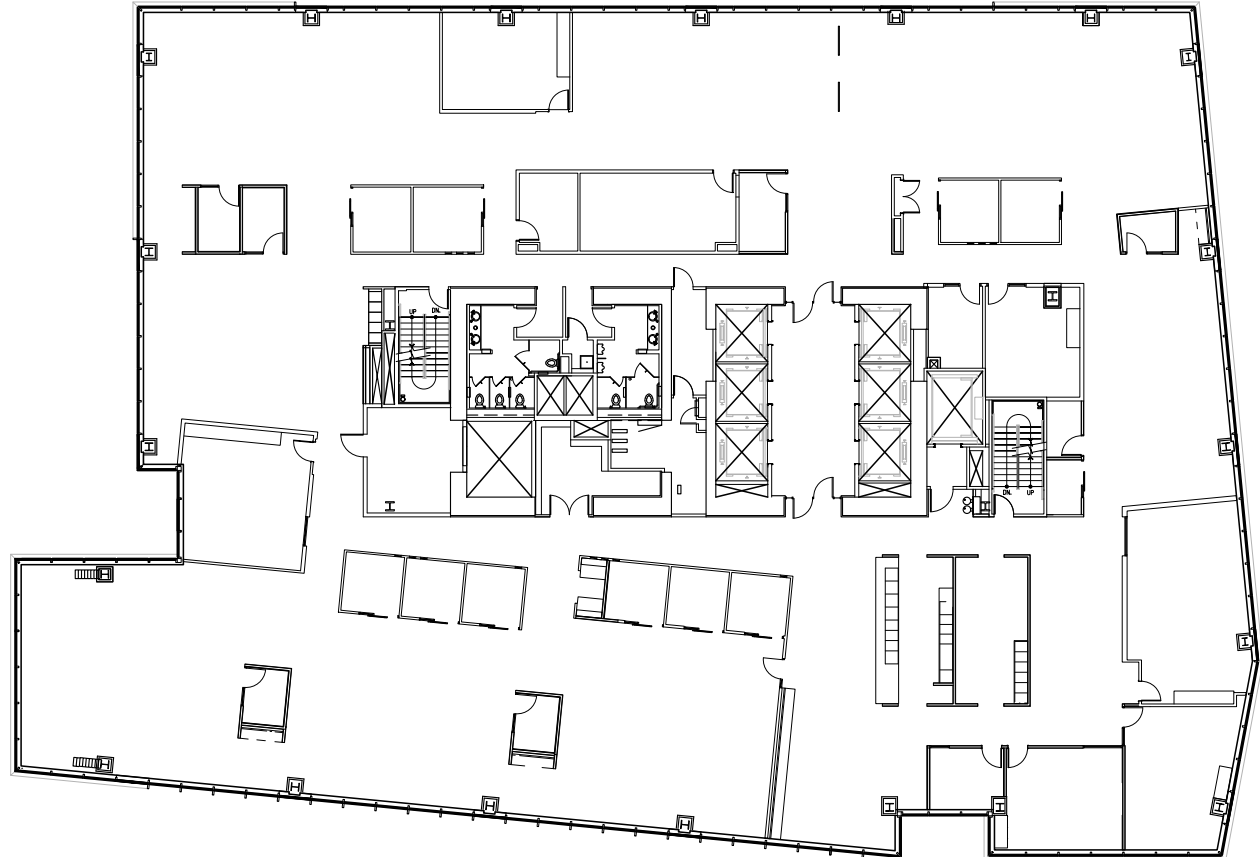

[BACK TO AVAILABILITIES](#)