

# LINCOLN SQUARE

## LINCOLN SQUARE NORTH

10401 NE 8<sup>th</sup>  
Bellevue, WA 98004



**BRODERICK**  
GROUP

For more information or to  
schedule a tour, please contact:

**PAUL SWEENEY**  
425.646.5225  
sweeney@broderickgroup.com

**JIM KINERK**  
425.646.5221  
kinerk@broderickgroup.com


**CLAYTON HOLM**  
425.274.4287  
holm@broderickgroup.com

# LINCOLN SQUARE NORTH

Floor 19 • 22,360 RSF • As-Built Plan

## SPACE FEATURES

- Available with 120 days notice
- Unobstructed Lake Washington and Seattle Skyline views
- Former Microsoft floor

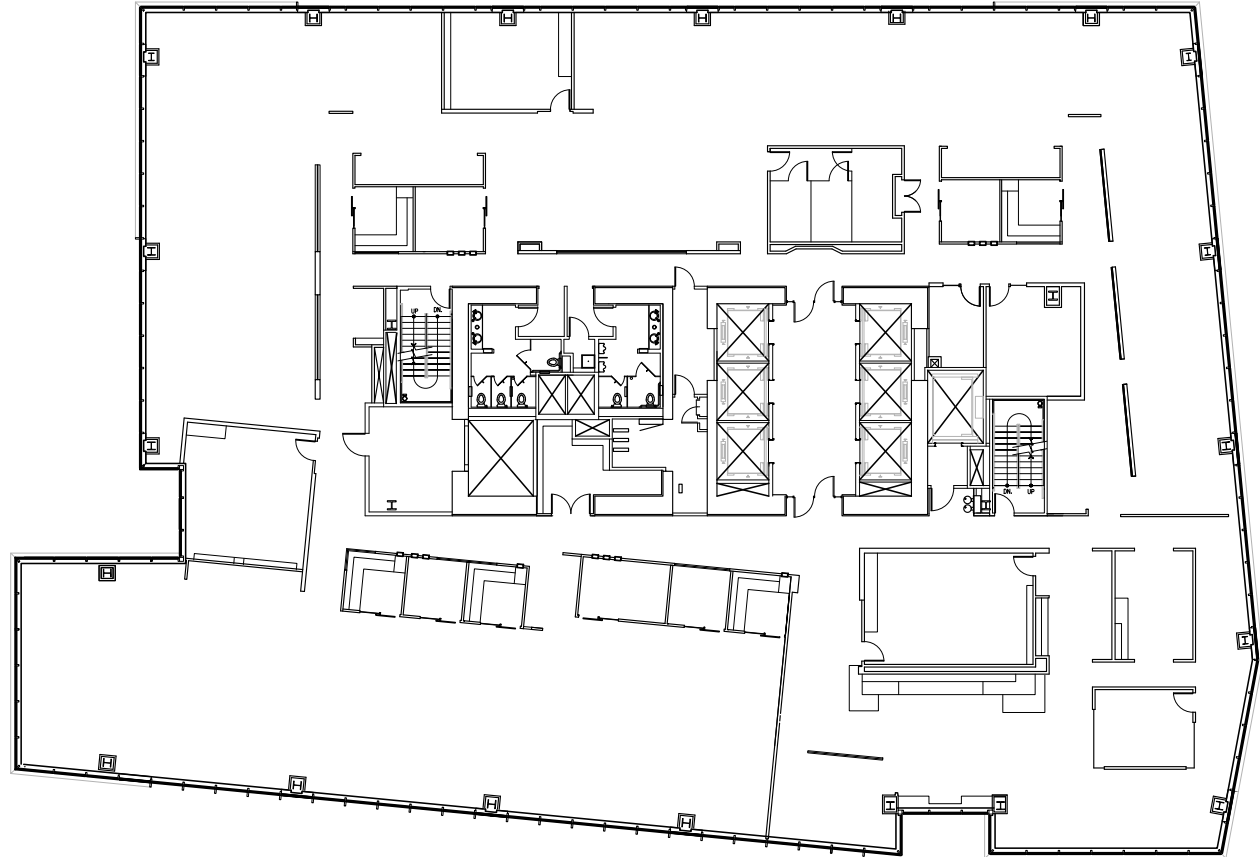

[BACK TO AVAILABILITIES](#)