



NORTHUP BUILDING

FOR MORE INFO
PLEASE CONTACT

TOM BOHMAN

Senior Vice President
+1 425 462 6911
tom.bohman@cbre.com

LENNON ATTEBERRY


First Vice President
+1 425 462 6991
lennon.attedberry@cbre.com

CBRE, INC.

929 108th Avenue NE
Suite 700
Bellevue, WA 98004

SUITE 301

AS-BUILT FLOOR PLAN | ±3,394 RSF

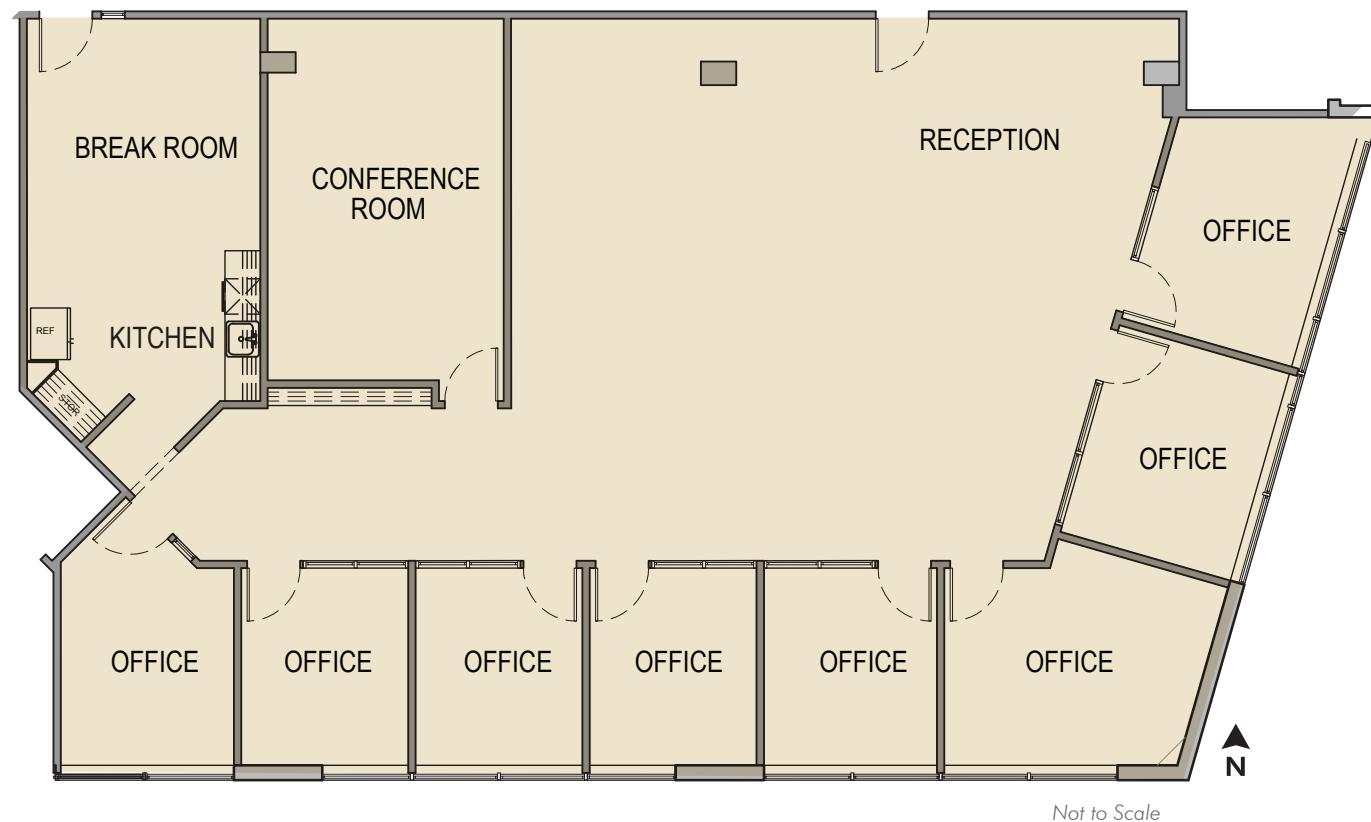

CBRE

© 2020 CBRE, Inc. All rights reserved. This information has been obtained from sources believed reliable, but has not been verified for accuracy or completeness. You should conduct a careful, independent investigation of the property and verify all information. Any reliance on this information is solely at your own risk. CBRE and the CBRE logo are service marks of CBRE, Inc. Photos herein are the property of their respective owners and use of these images without the express written consent of the owner is prohibited. PMStudio_October2020



NORTHUP BUILDING

FOR MORE INFO
PLEASE CONTACT

TOM BOHMAN

Senior Vice President
+1 425 462 6911
tom.bohman@cbre.com

LENNON ATTEBERRY


First Vice President
+1 425 462 6991
lennon.attedberry@cbre.com

CBRE, INC.

929 108th Avenue NE
Suite 700
Bellevue, WA 98004

SUITE 301

CONCEPTUAL FLOOR PLAN | ±3,394 RSF

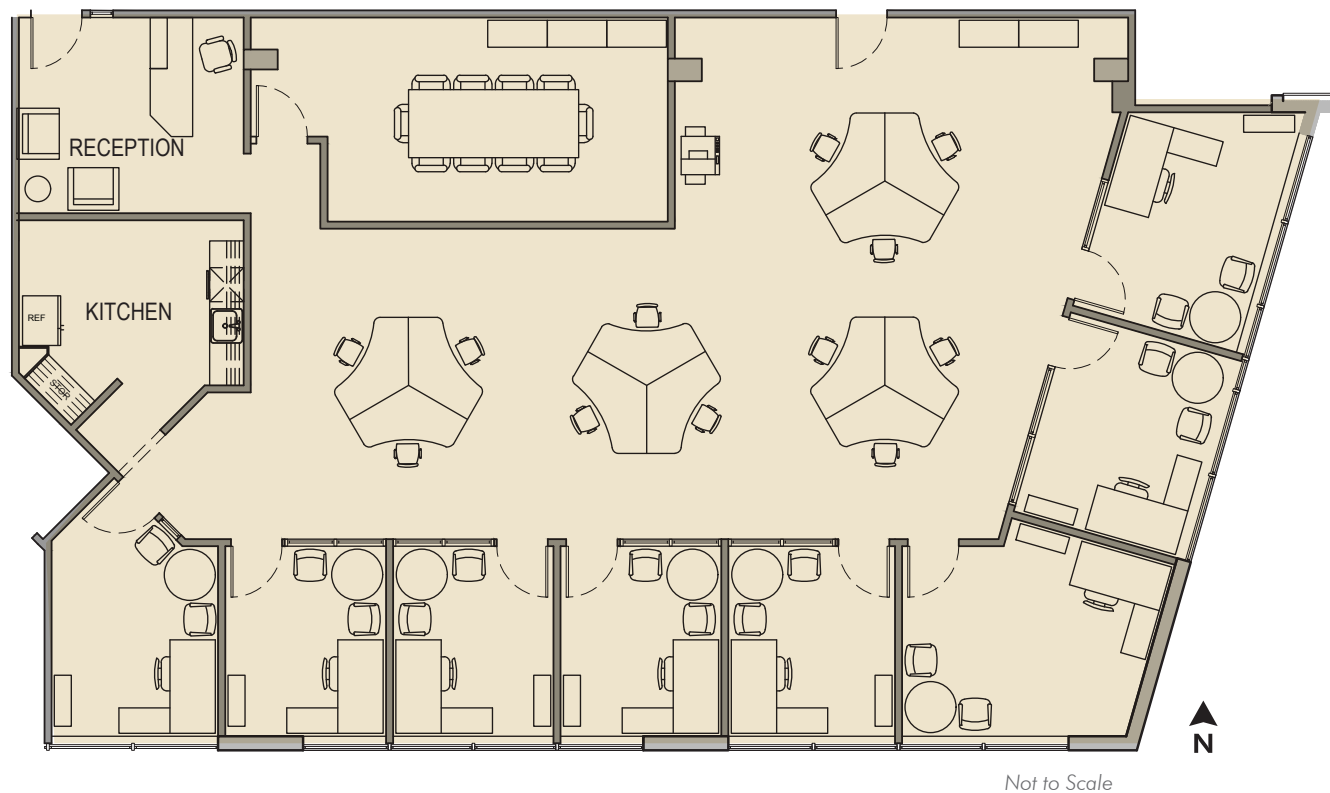

CBRE

© 2020 CBRE, Inc. All rights reserved. This information has been obtained from sources believed reliable, but has not been verified for accuracy or completeness. You should conduct a careful, independent investigation of the property and verify all information. Any reliance on this information is solely at your own risk. CBRE and the CBRE logo are service marks of CBRE, Inc. Photos herein are the property of their respective owners and use of these images without the express written consent of the owner is prohibited. PMStudio_October2020



NORTHUP BUILDING

FOR MORE INFO
PLEASE CONTACT

TOM BOHMAN

Senior Vice President
+1 425 462 6911
tom.bohman@cbre.com

LENNON ATTEBERRY

First Vice President
+1 425 462 6991
lennon.attedberry@cbre.com


CBRE, INC.

929 108th Avenue NE
Suite 700
Bellevue, WA 98004

CBRE

SUITE 301

CONCEPTUAL FLOOR PLAN | ±3,394 RSF

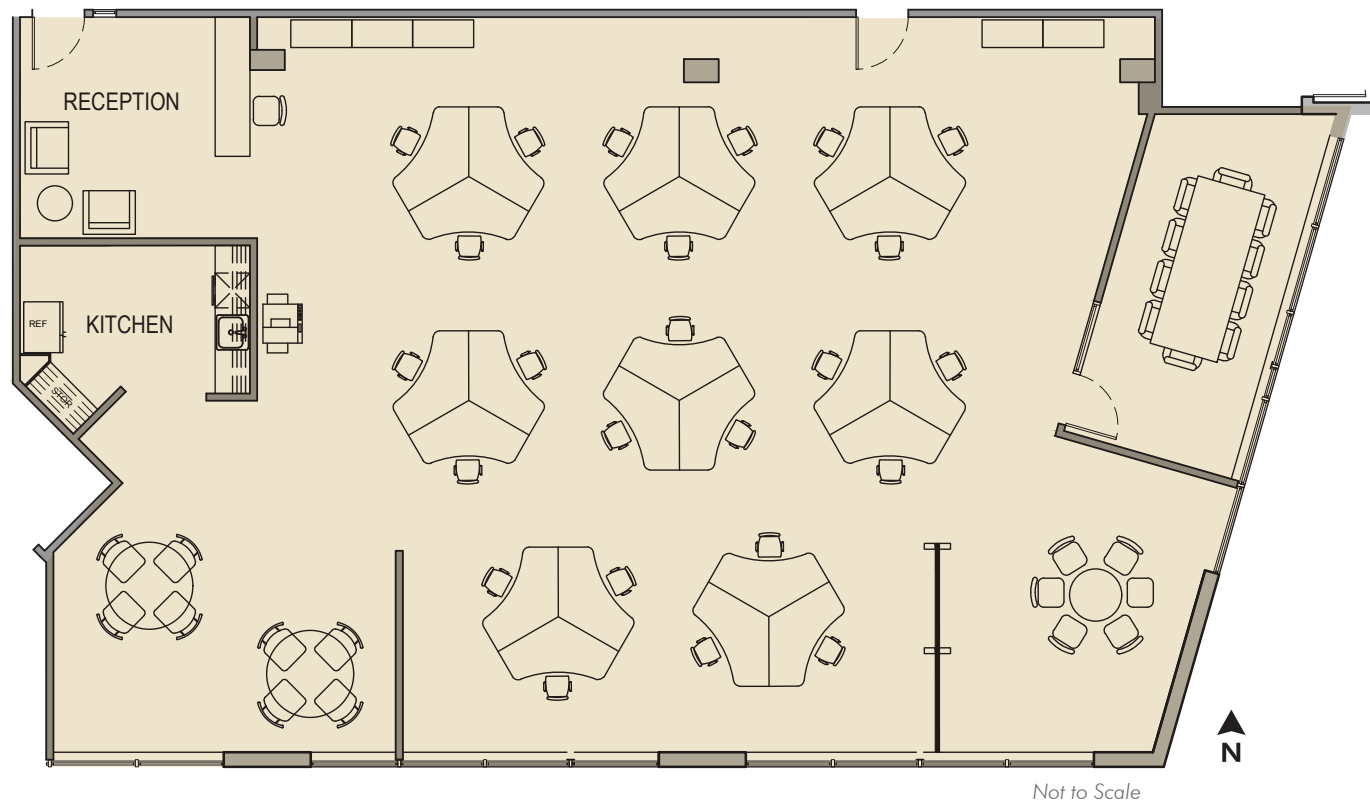

© 2020 CBRE, Inc. All rights reserved. This information has been obtained from sources believed reliable, but has not been verified for accuracy or completeness. You should conduct a careful, independent investigation of the property and verify all information. Any reliance on this information is solely at your own risk. CBRE and the CBRE logo are service marks of CBRE, Inc. Photos herein are the property of their respective owners and use of these images without the express written consent of the owner is prohibited. PMStudio_October2020