

1 FLOOR PLAN  
1/4" = 1'-0"


7/22/2020 1:00:25 PM

REVISIONS

DATE 07.22.20

PROJECT NUMBER 20134

SHEET NUMBER  
**A-100**

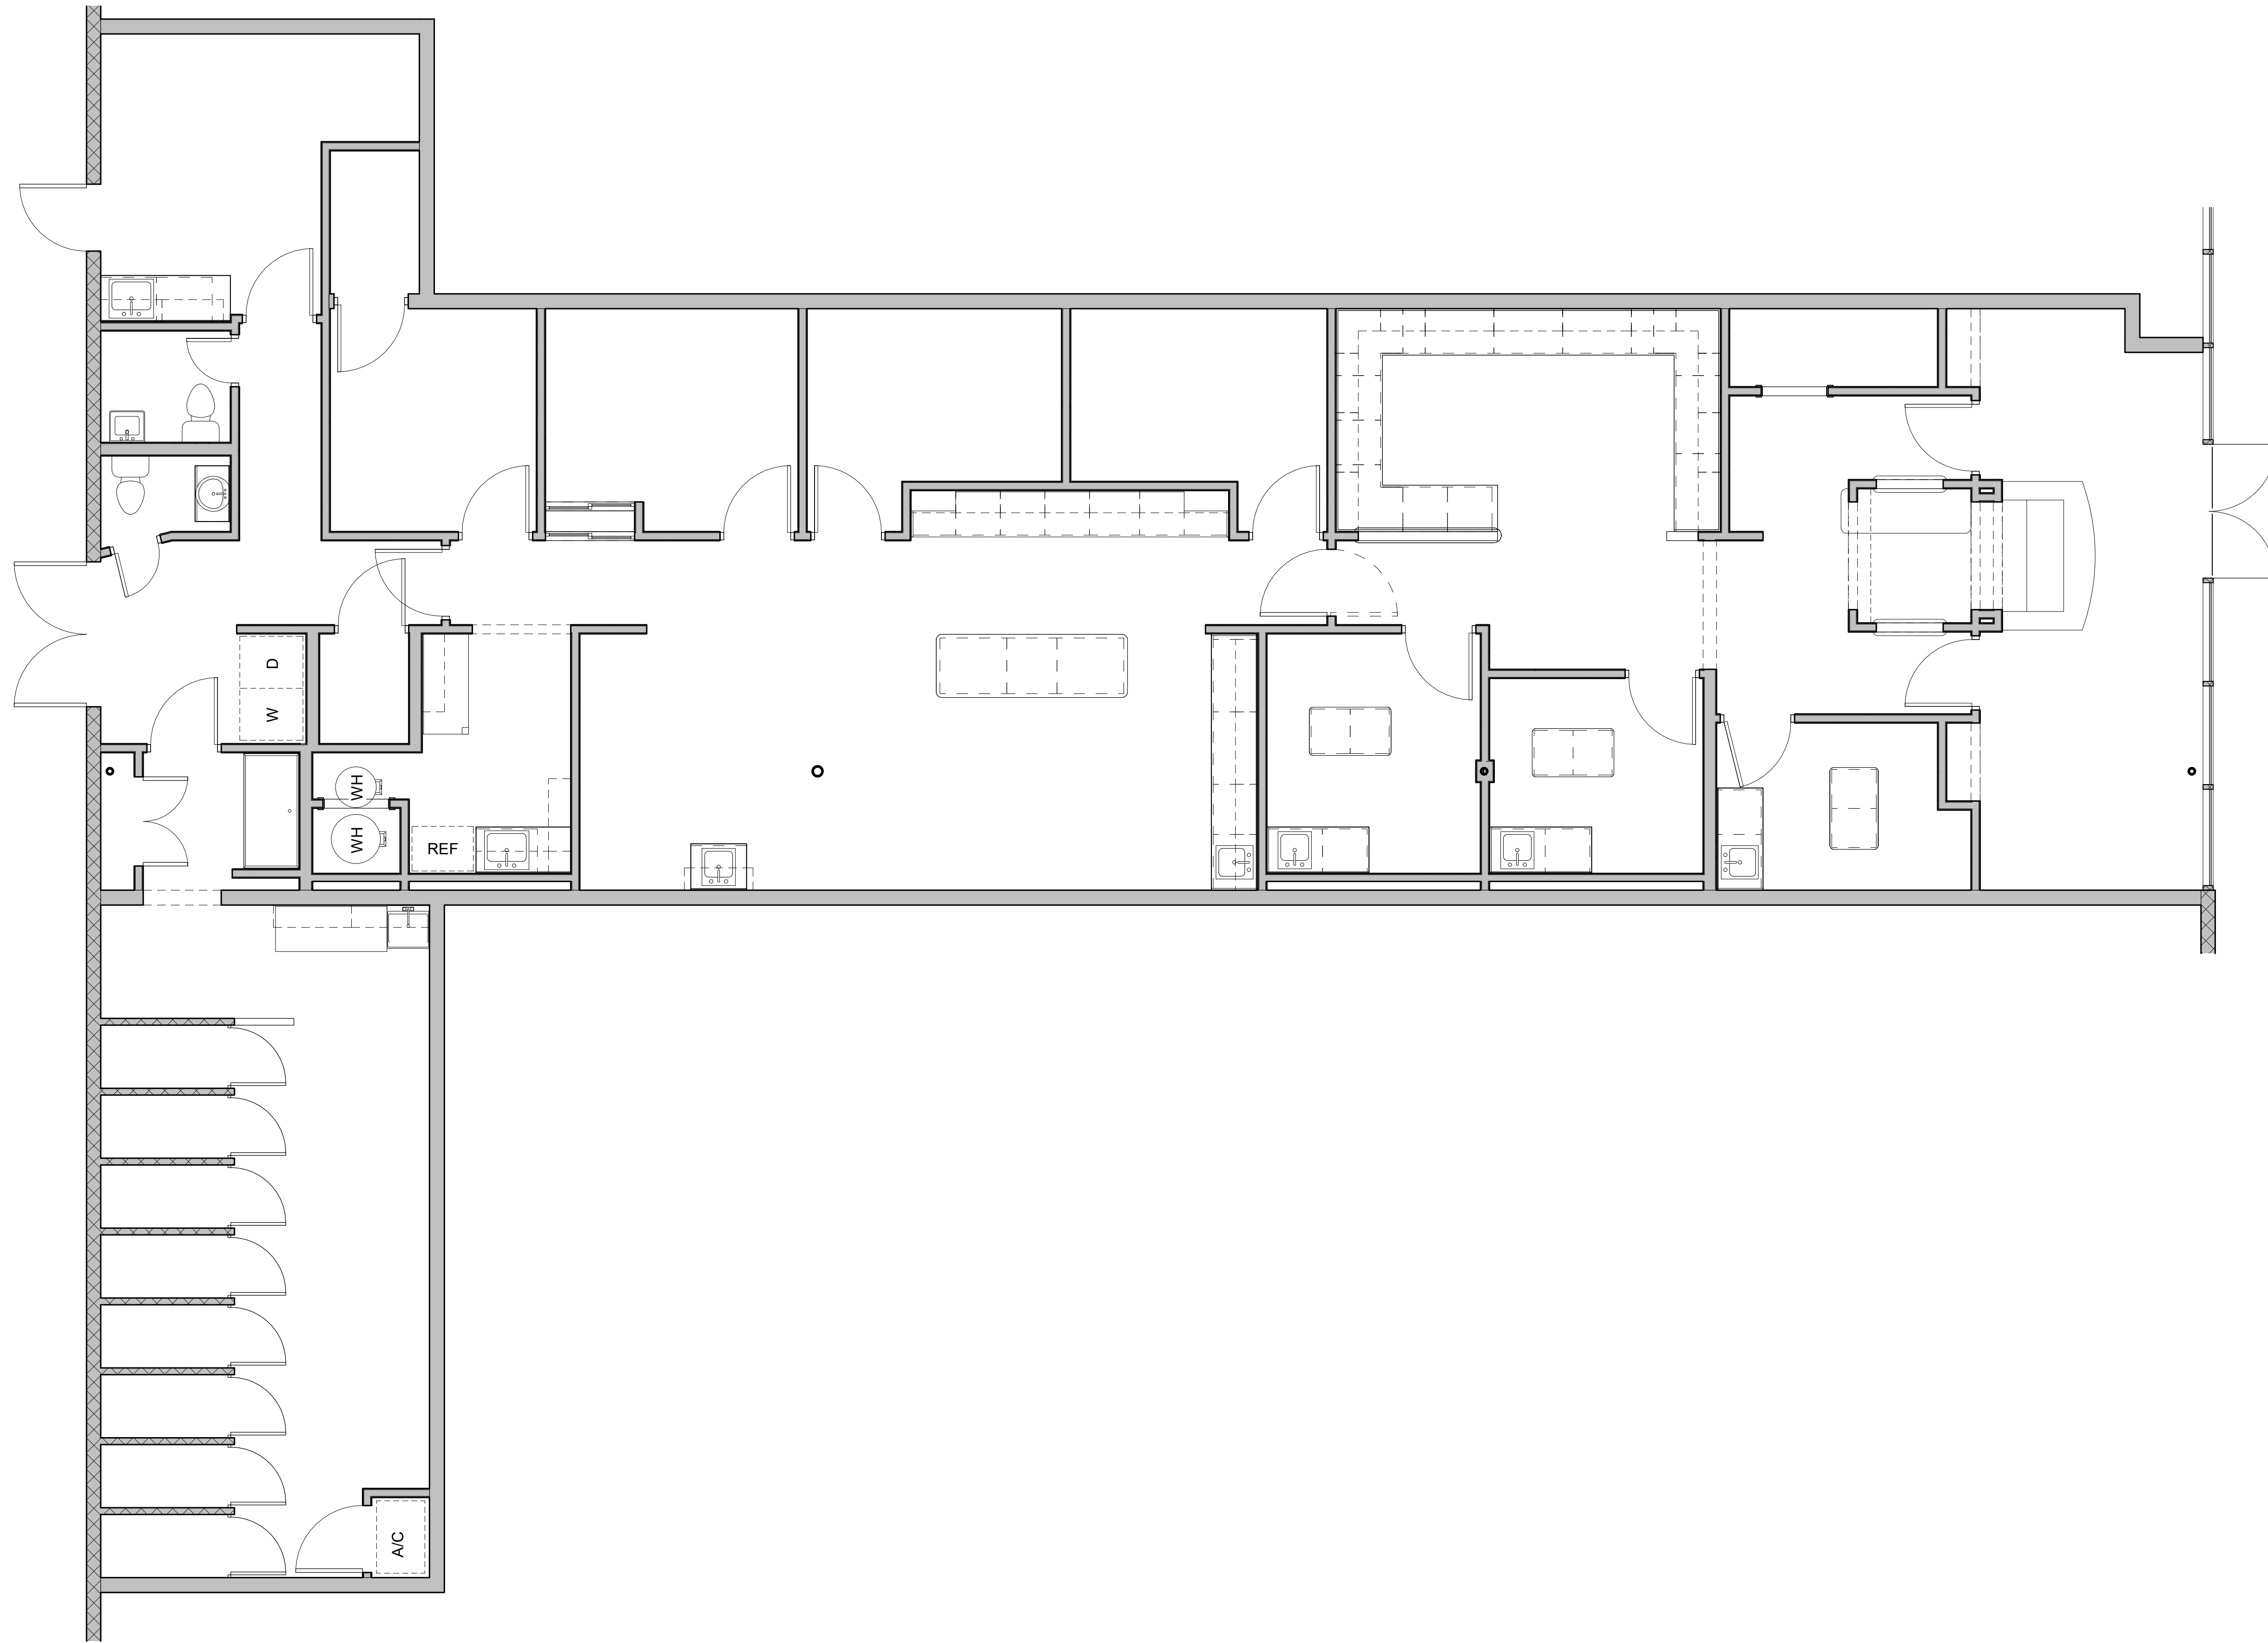

1 FLOOR PLAN  
1/4" = 1'-0"

7/22/2020 1:00:26 PM

REVISIONS

DATE 07.22.20

PROJECT NUMBER 20134

SHEET NUMBER  
**A-101**

**PITT ST**

**ROBERT ST**




**LYONS ST**

**PRYTANIA ST**

NOT IN SCOPE  
14859 SF

RENTABLE  
3084 SF

NOT IN SCOPE  
14859 SF

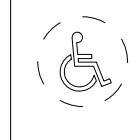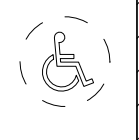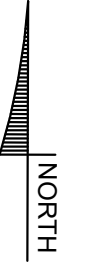

**ga** garity + accardo  
a r c h i t e c t s

A PROFESSIONAL CORPORATION  
2401 WHITNEY AVENUE  
GRETNIA LOUISIANA 70056  
PHONE 504-366-4475  
www.garityaccardo.com

PROJECT  
**4907 PRYTANIA ST**  
AS-BUILT DRAWINGS

SHEET TITLE  
**AREA / SITE PLAN**

REVISIONS

DATE 07.22.20

PROJECT NUMBER 20134

SHEET NUMBER **C-100**

7/22/2020 1:00:28 PM

② AREA / SITE PLAN  
3/32" = 1'-0"