




Adjacent Suite

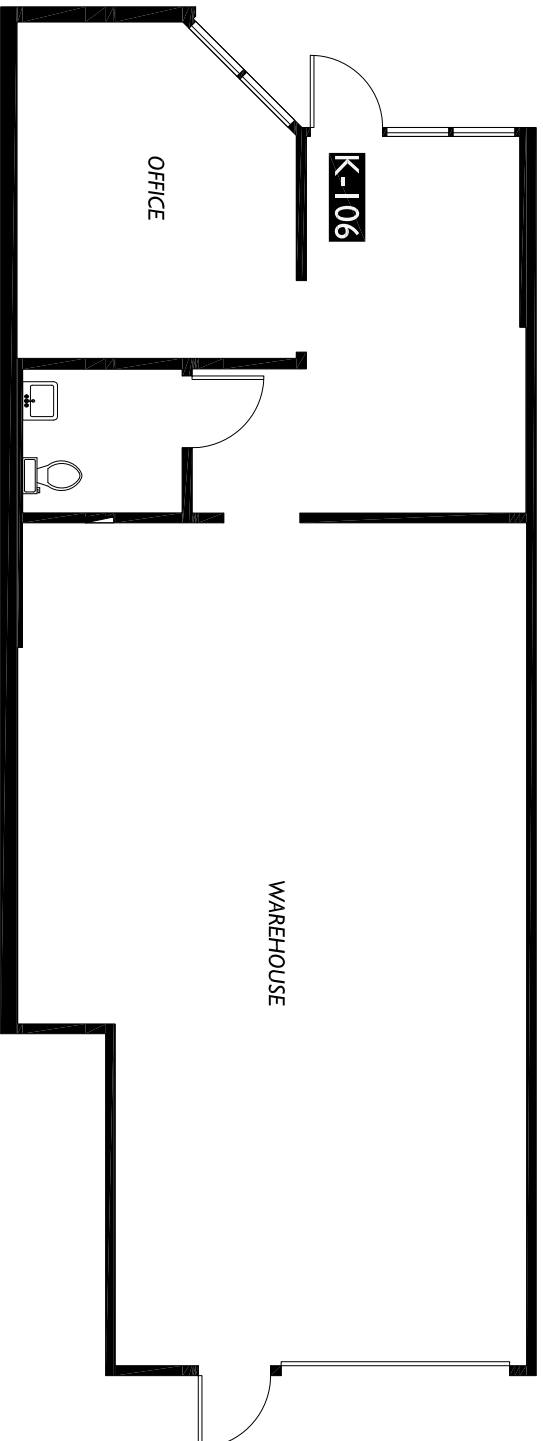

Adjacent Suite

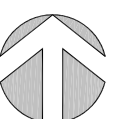

West Valley Buisness Park 6625 S 190th Street Suite B-104 Kent, WA 98032		West Valley Buisness Park 6625 S 190th Street Kent, WA 98032		Suite Plan <b>K-106</b>		1/8" = 1'-0"		 2DFLOORPLANS.COM 206-328-7410 fax 206-328-4764 AS-BUILT FLOOR PLANS 1700 21st Avenue South Suite 100 Seattle, WA 98144			
Client		Subject		Floor		Scale		Measured: November 2014		Project: C14-749	