


SUITE 204 & 206 AS-BUILT FLOOR PLAN
3084 (+/-) COMBINED SF - WITHOUT DIMENSIONS

SCALE - 1/4" = 1' - 0"

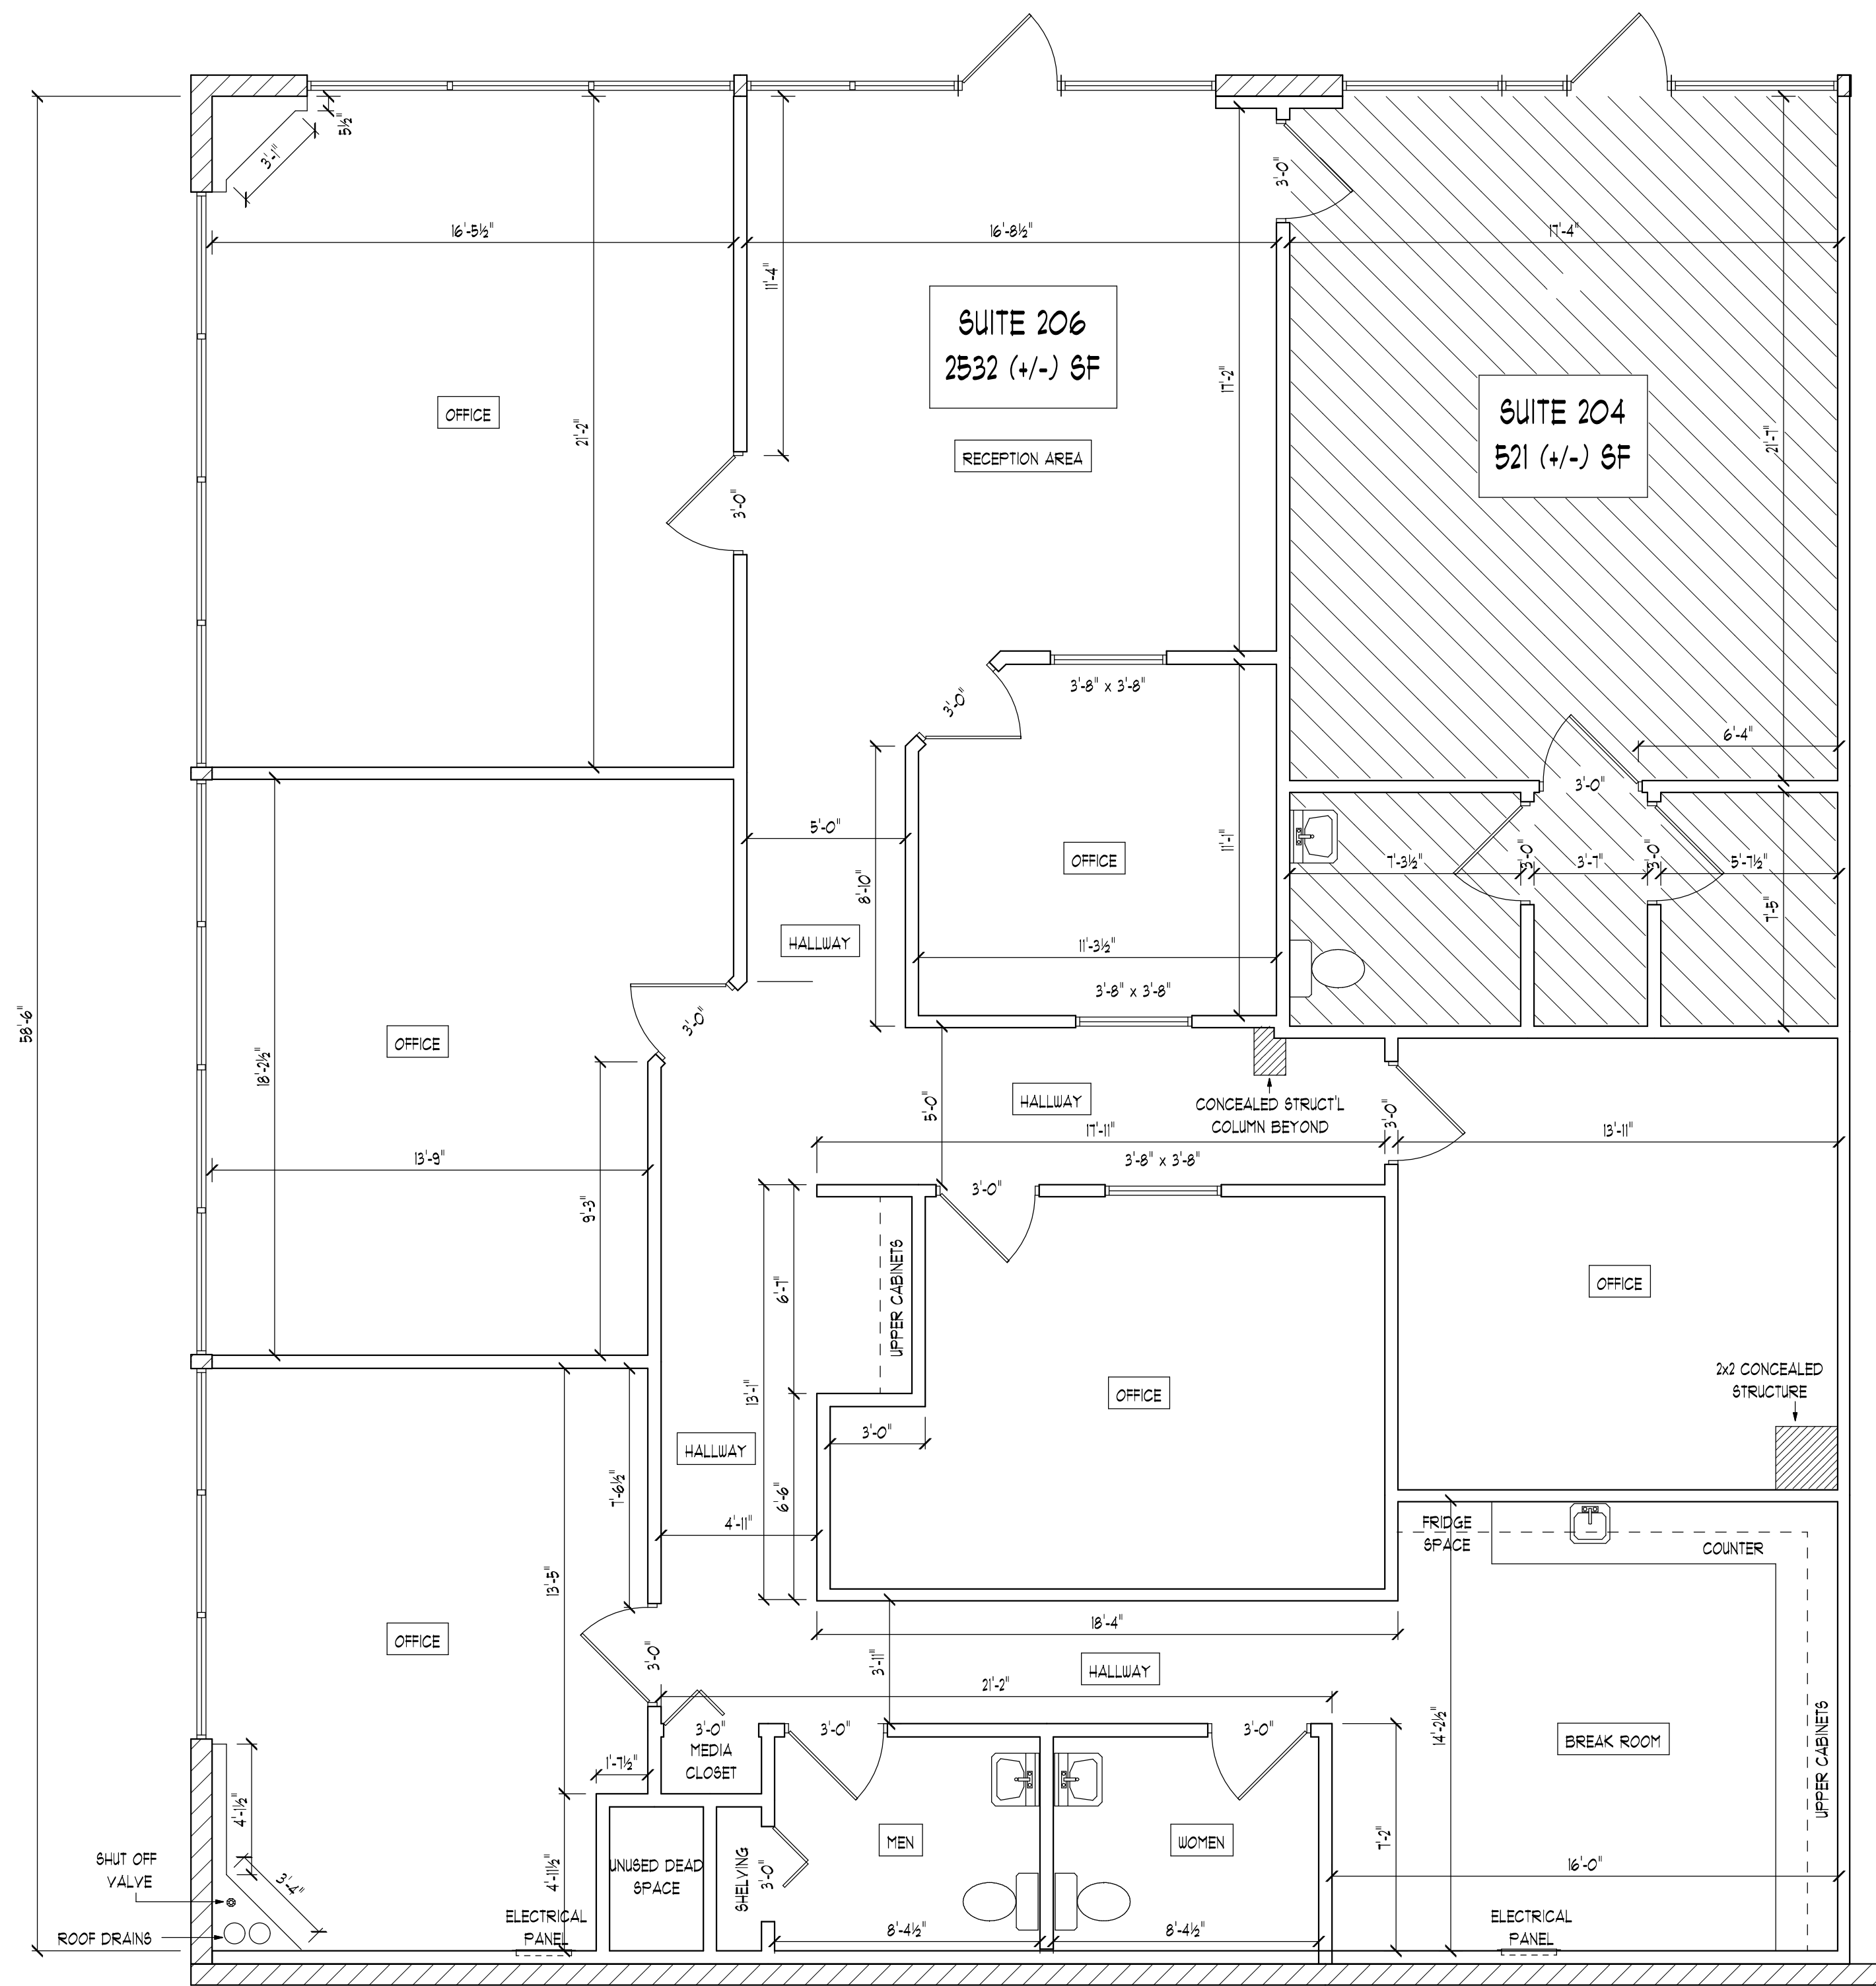

SUITE 204 & 206 AS-BUILT FLOOR PLAN
3084 (+/-) COMBINED SF

SCALE - 1/4" = 1' - 0"

REVISIONS

1	
2	
3	
E. THUNDERBIRD SQUARE
 14202 N. Scottsdale Rd.
 Scottsdale, AZ 85254

SUITE 204 & 206 AS-BUILT
FLOOR PLAN

PREPARED BY:
 Harry Young
 Design & Drafting
 Design
 Drafting
 Mbl: (602) 909-8889
 www.HarryYoungDrafting.com

DRAWN BY:
 HARRY YOUNG

SCALE:
 1/4" = 1'-0"

DATE:
 12-13-16

SHEET NUMBER