


Lower Level
16,617 RSF
As-built

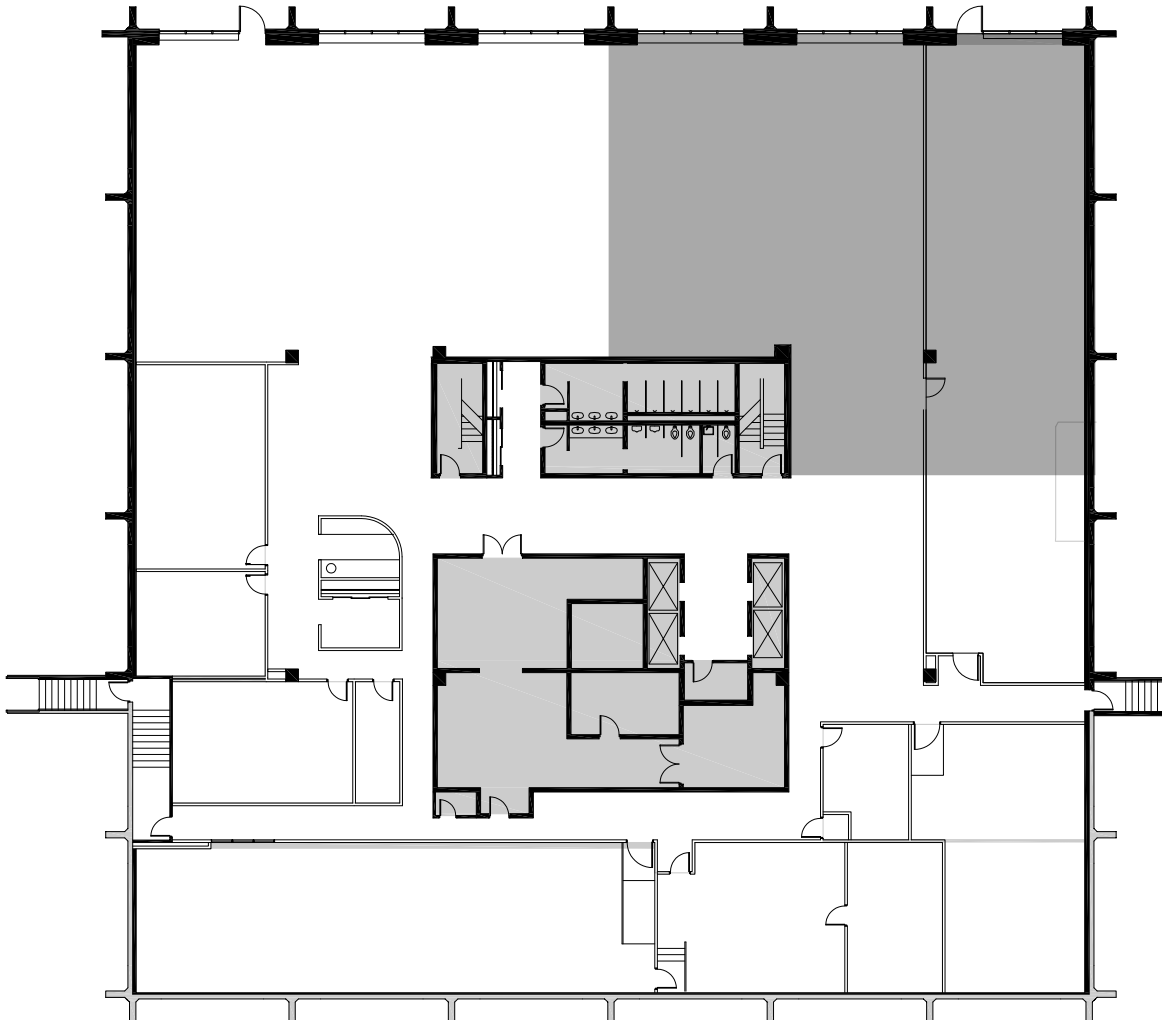

Leasing and Marketing by:

**Newmark Grubb
Knight Frank**

Jamie Gard
jgard@ngkf.com
303.260.4341

Courtney Hasson
chasson@ngkf.com
303.260.4428

Owned and Managed by:

M&J WILKOW