

RIDGEWOOD


CORPORATE SQUARE
a **KBS** property

BUILDING B

Suite 107: 1,557 RSF

As-Built Plan

Available: 30 Days Notice

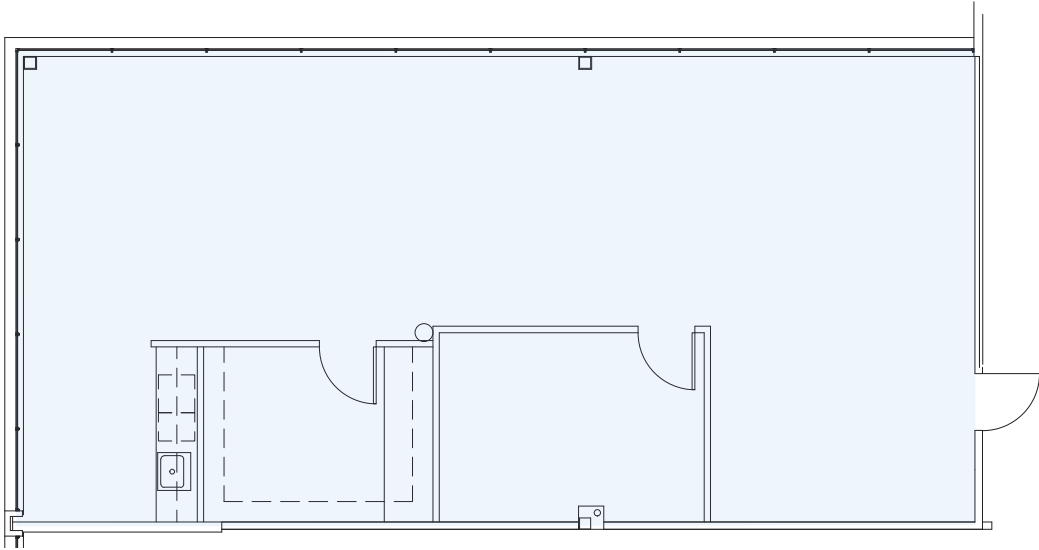

FOR MORE INFORMATION

Scott Davis

425.462.6912
scott.davis@cbre.com

Cortney Schirman

425.462.6975
cortney.schirman@cbre.com

Proudly leased
and managed by

