


IF THIS SHEET DOES NOT MEASURE TO 11 x 17, IT HAS BEEN ENLARGED OR REDUCED. ADJUST SCALE ACCORDINGLY.

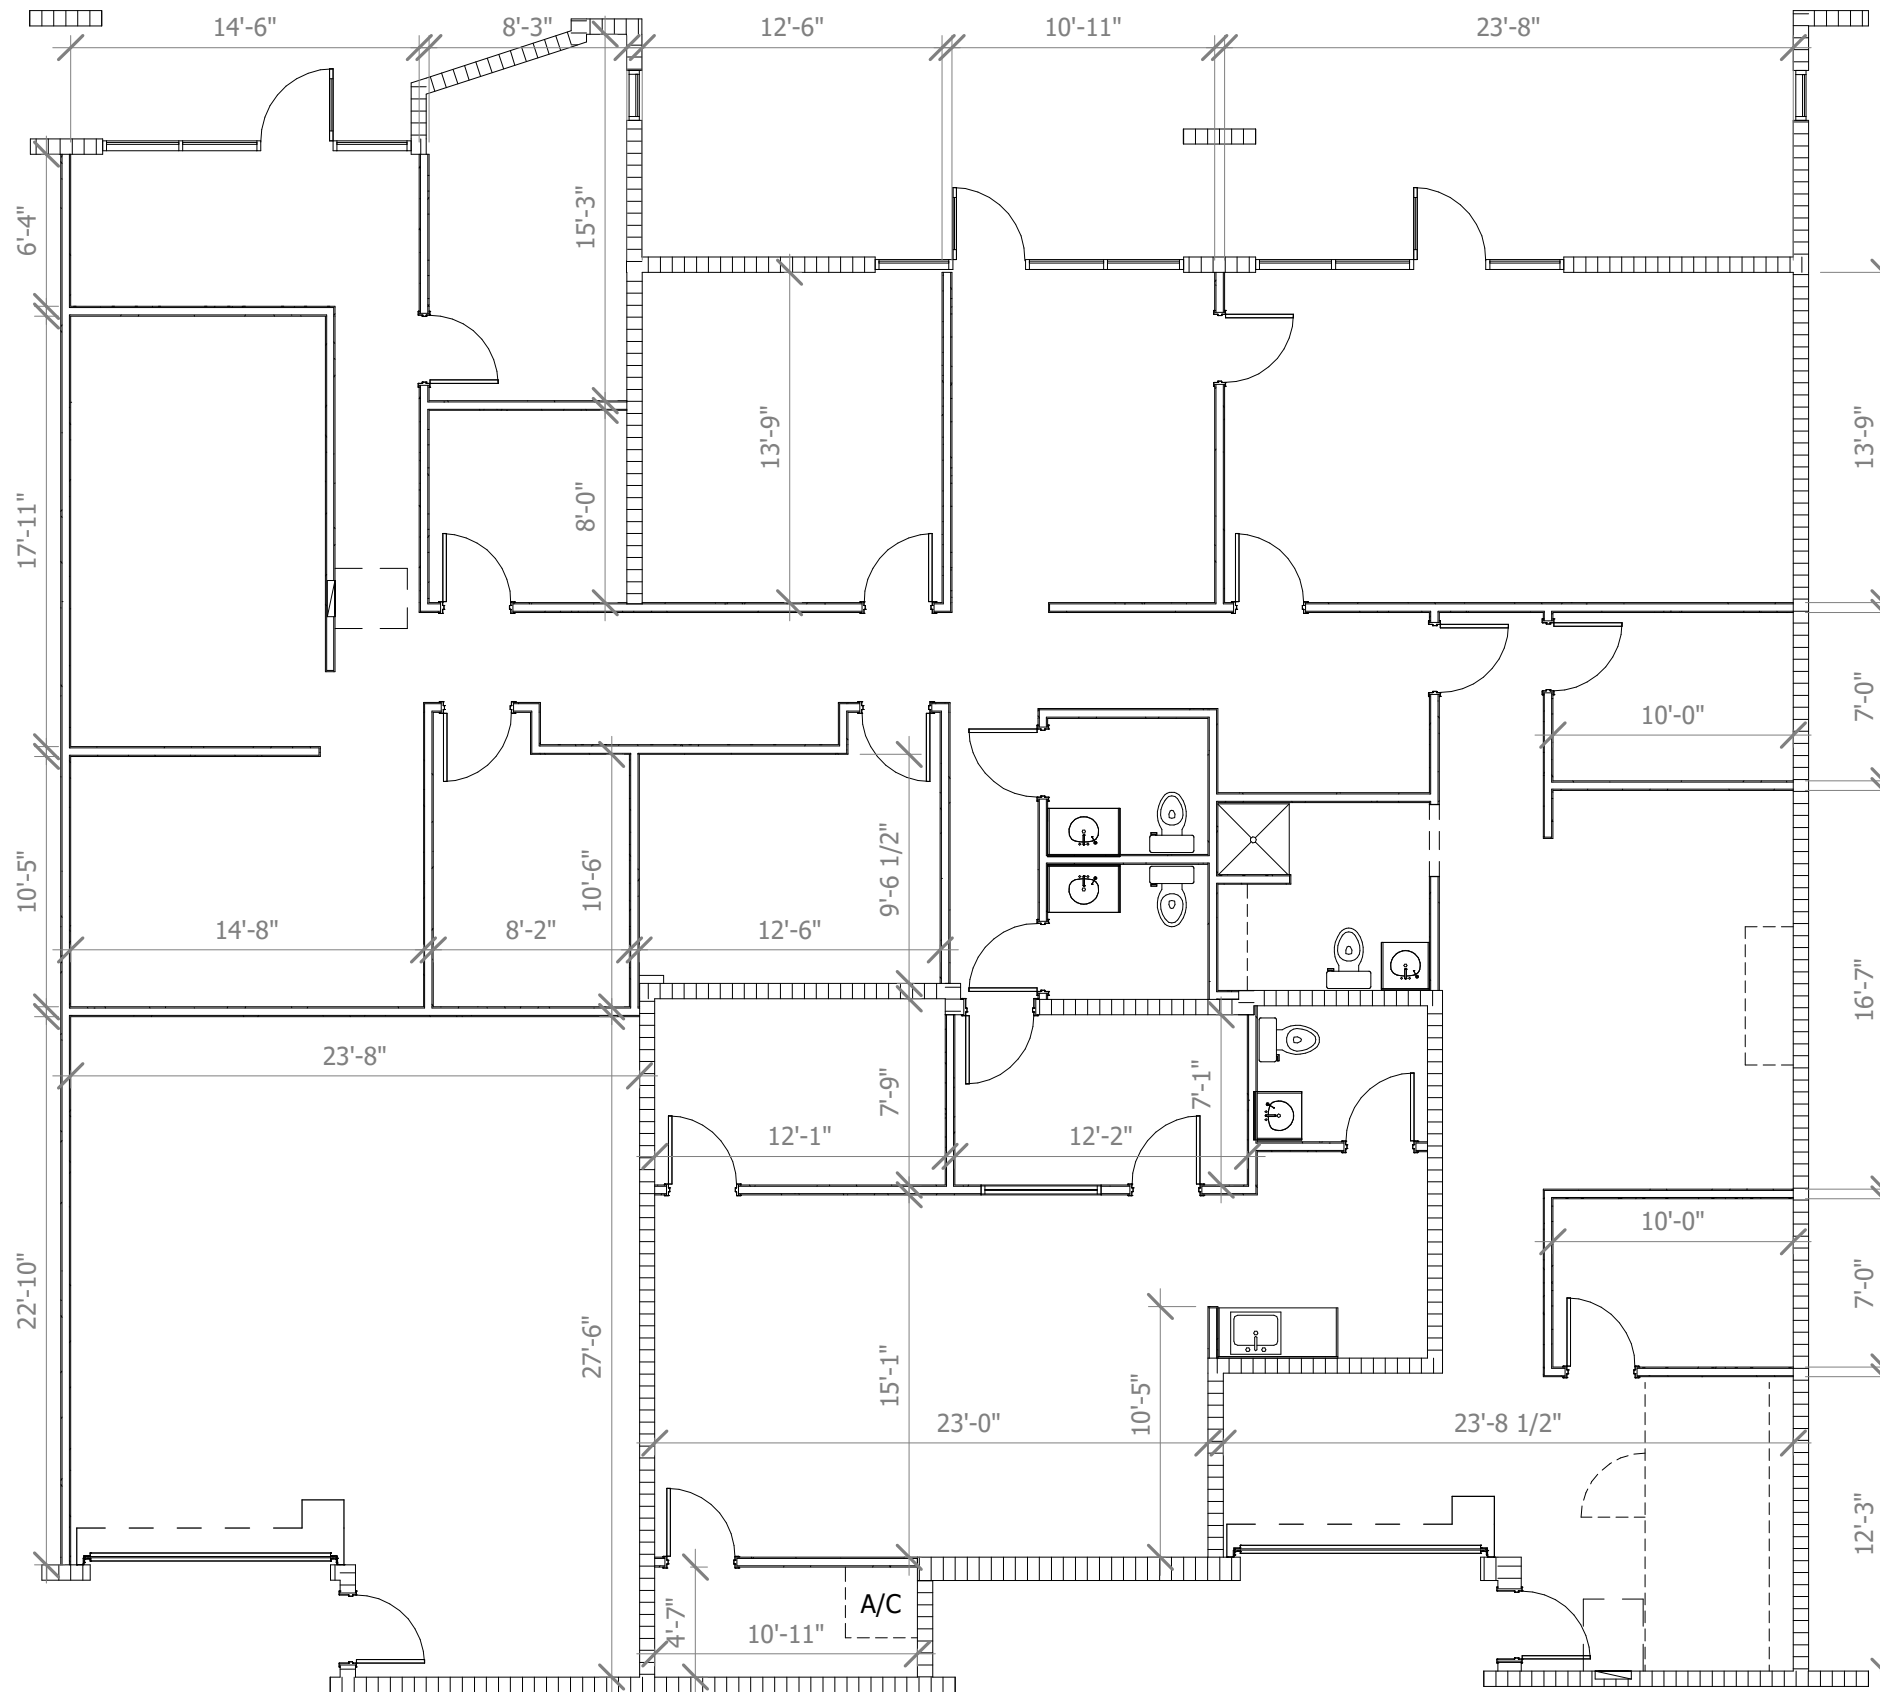

SCOTT + CORMIA

ARCHITECTURE + INTERIORS

429 S. Keller Road, Suite 200
Orlando, Florida 32810
t. 407-660-2766
http://www.scottcormia.com
© copyright 2018 All Rights Reserved

project

QUORUM- J 6-8 AS-BUILT
EXISTING FLOORPLAN

4209 VINELAND ROAD
ORLANDO, FL 32811

seal

sheet info

PROJECT NUMBER	17005
DRAWN BY	DS
CHECKED BY	KG
SHEET NAME	EXISTING FLOORPLAN
ISSUE DATE	2018 JUN 27

2018 JUN 27

EX-01