


**THE TORONTO BUILDING (2000 P STREET NW)**

**SUITE 503**

**1,304 RSF**

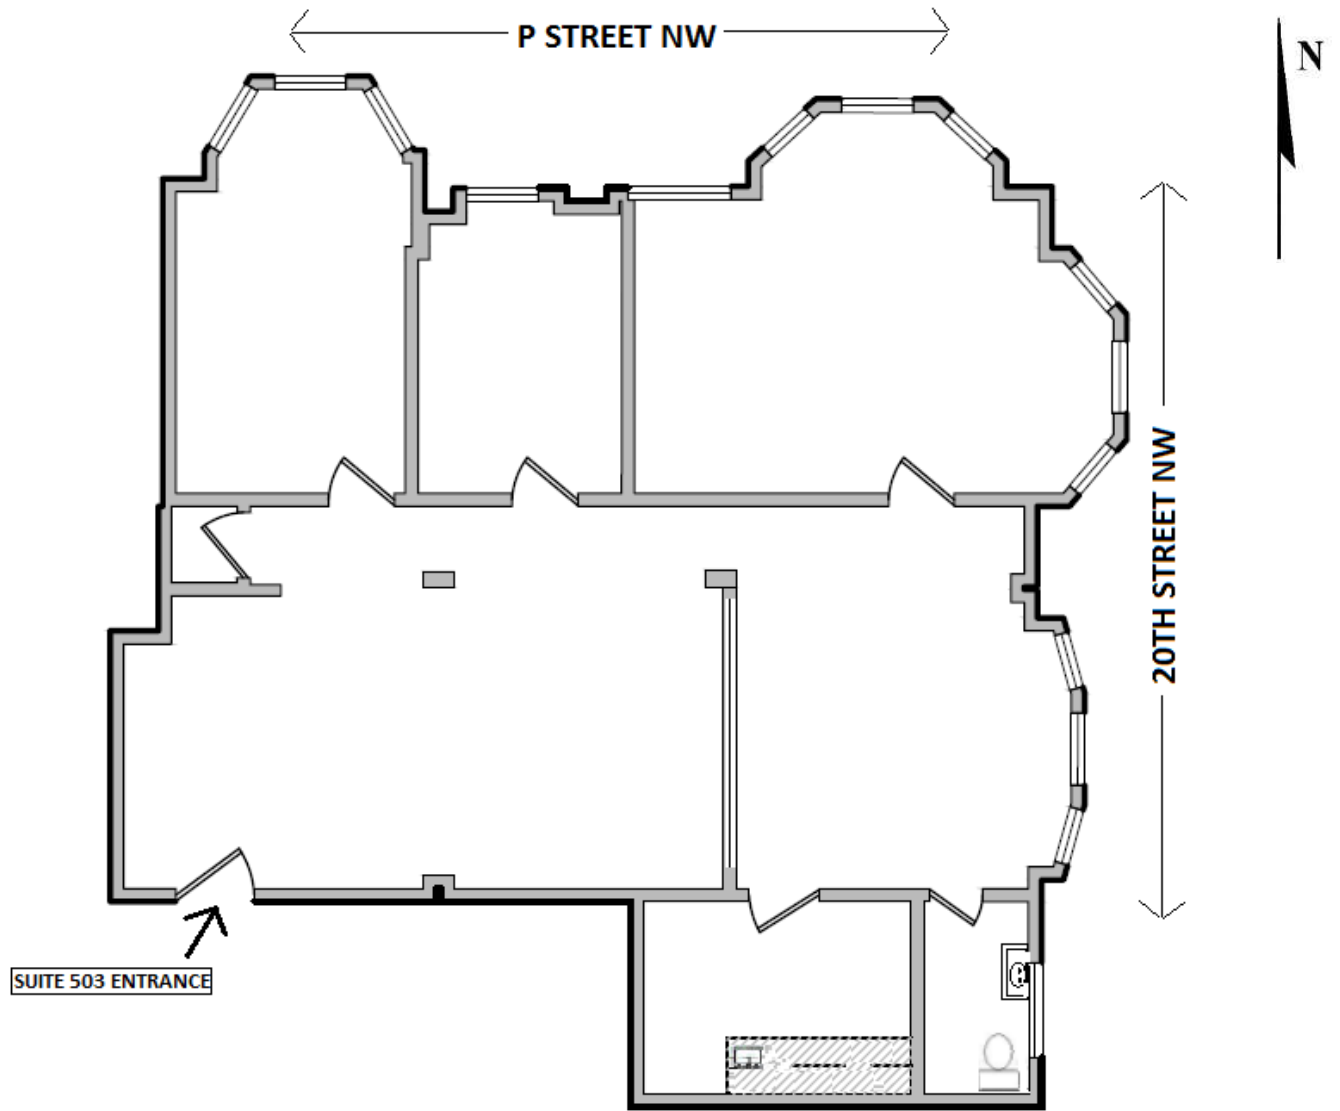

NOT TO SCALE. IMAGE AND DIMENSIONS ARE APPROXIMATE AND SUBJECT TO VERIFICATION.

02/07/20