


NEW ENGLAND BUILDING
219 1st Avenue South
Seattle, WA

2nd FLOOR

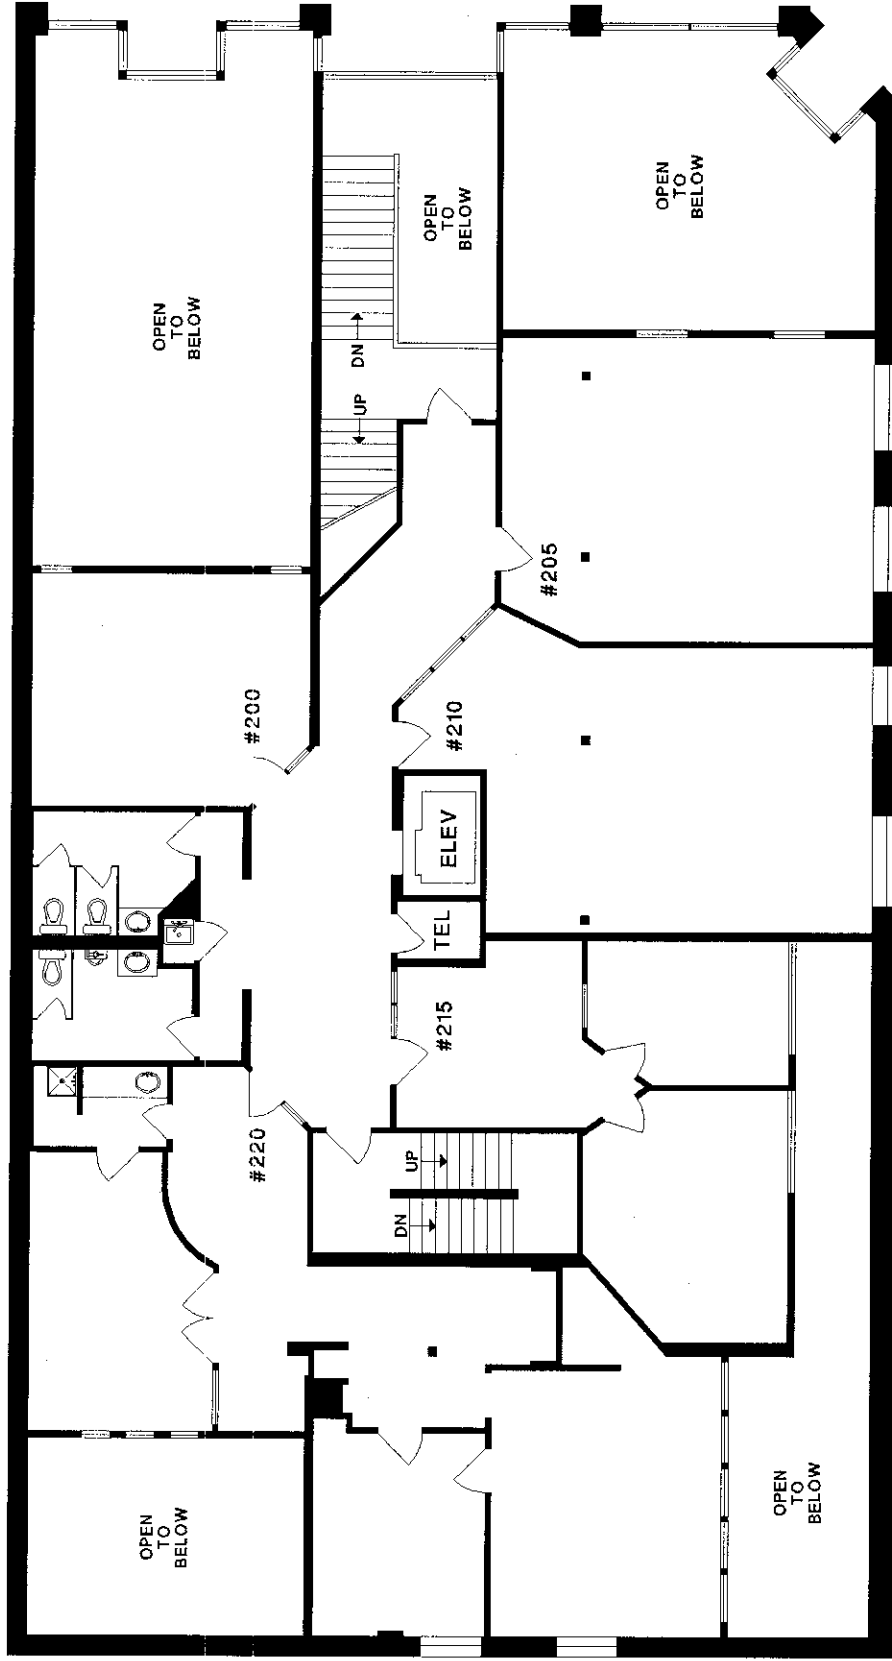

AS BUILT
FLOOR PLANS
DATE: 11/17/00
(206)284-4887