

RIDGEWOOD


CORPORATE SQUARE
a **KBS** property

BUILDING G

Suite 100: 5,147 RSF

As-Built Plan

Available: March 1, 2021

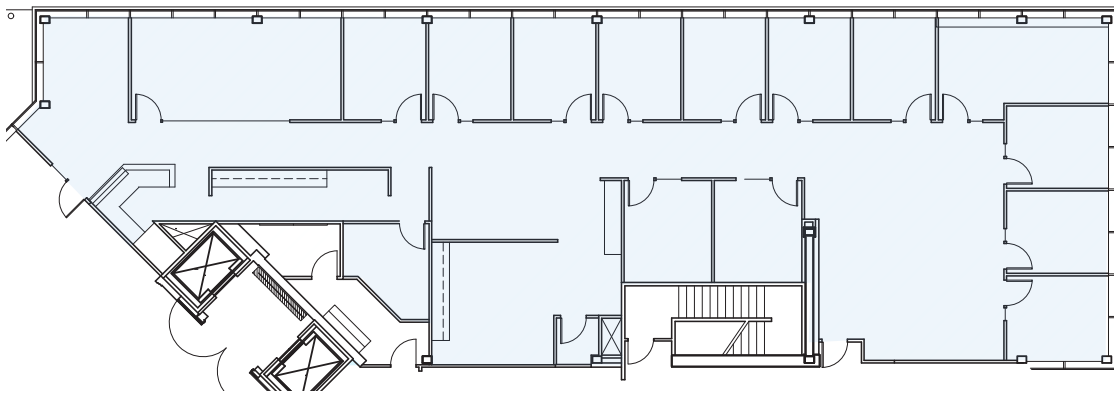

**FOR MORE
INFORMATION**

Scott Davis

425.462.6912
scott.davis@cbre.com

Cortney Schirman

425.462.6975
cortney.schirman@cbre.com

Proudly leased
and managed by

CBRE