

Cornerstone Properties

5401 Old Redwood Hwy, Suite 110
 Redlands, CA 94954
 o 707.526.4799
 f 707.792.2902

This document and the information contained herein are the property of Cornerstone Properties. Unauthorized use, copying, disclosure or publication by any method is prohibited without the written approval of Cornerstone Properties.

STAMP:

CONSULTANT:

LOCATION:

150 Todd Road
 Santa Rosa, CA

PROJECT NAME:

As Builts
 TR-170

DRAWING NAME:

**SUITES #100, #200,
 #205, & #900
 FLOOR PLAN**


Revision: Date:

Revision:	Date:


ISSUED FOR: As-Builts
 DATE: May 9, 2016
 SCALE: AS SHOWN
 DRAWN: r2k_CDD Services

SHEET


TR-170-1

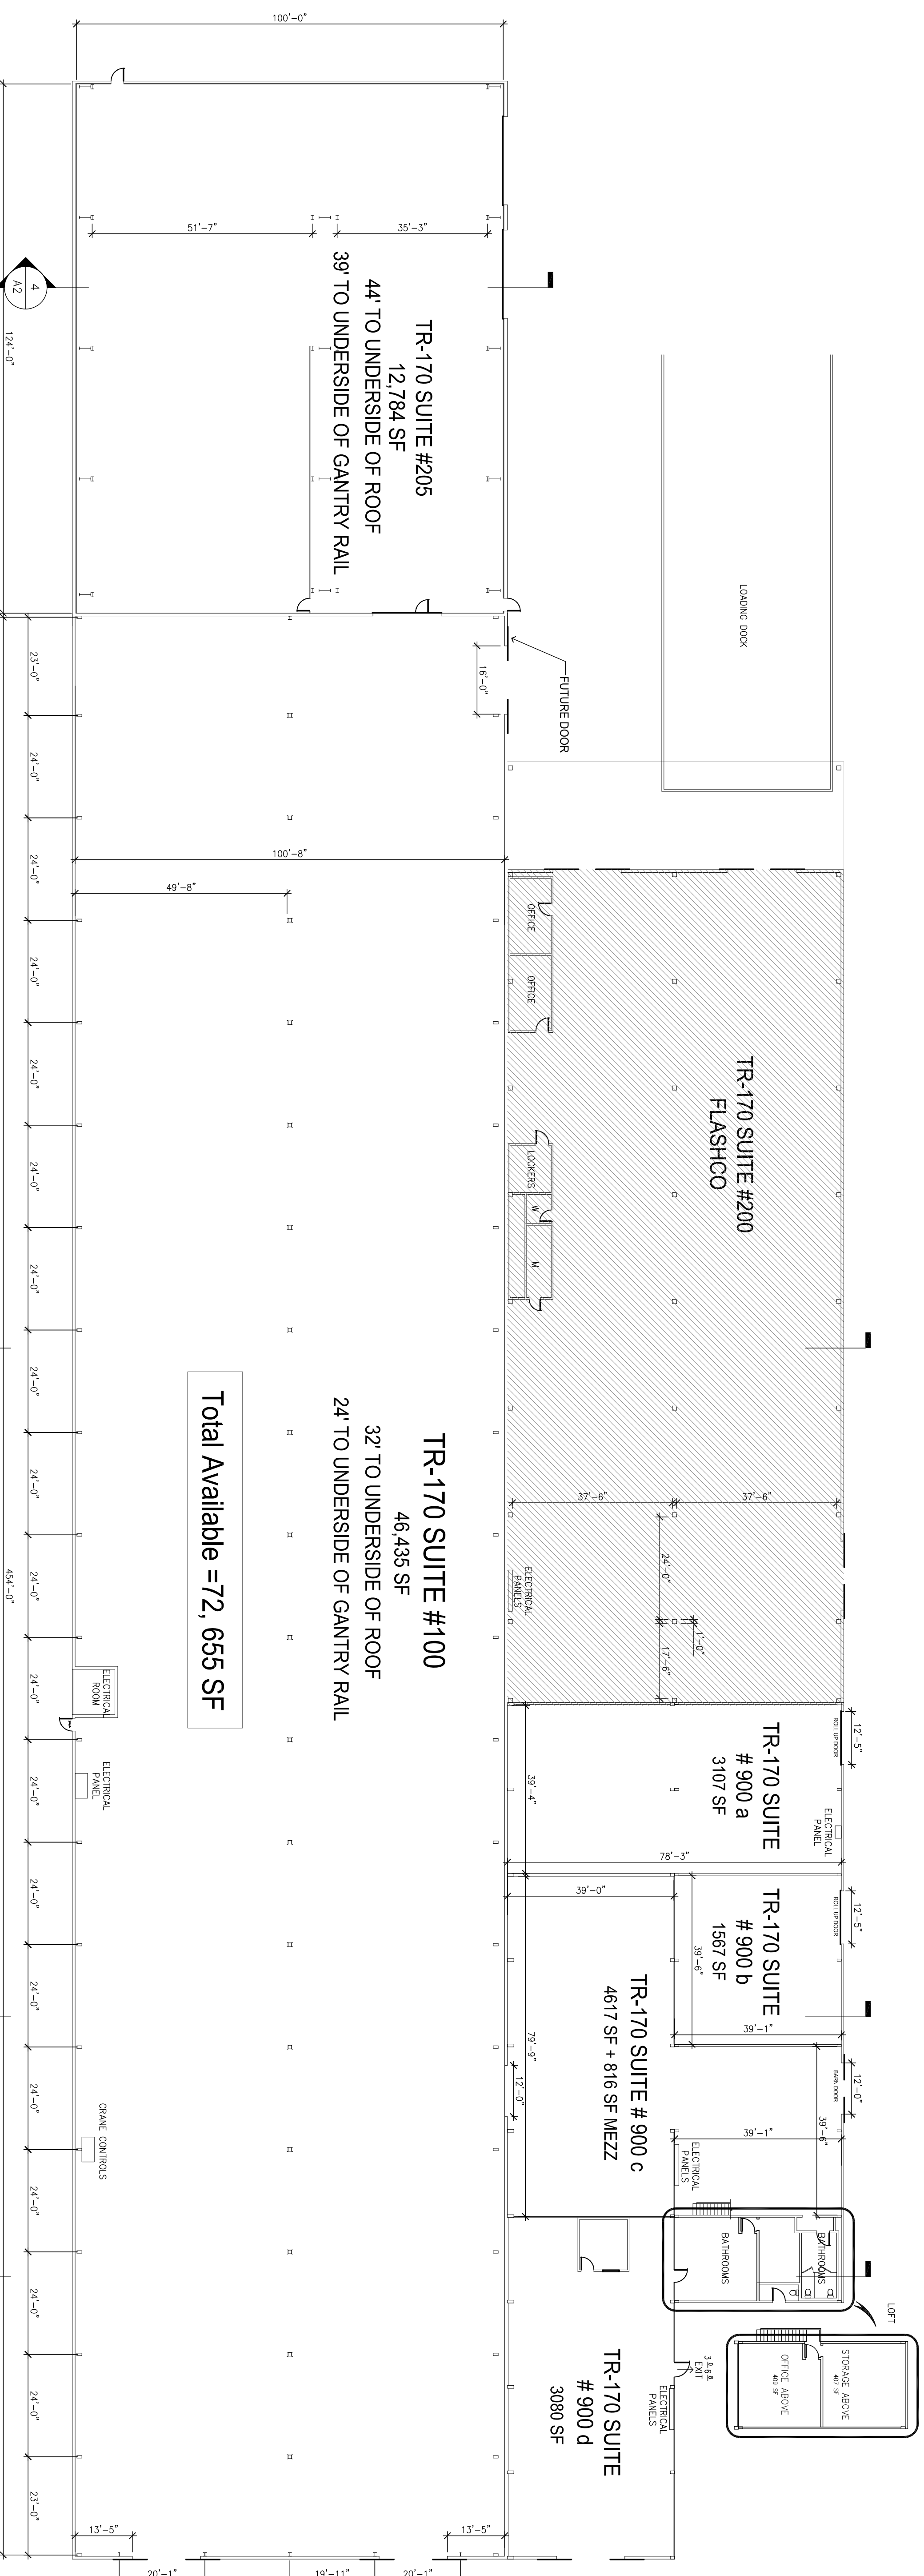

Total Available = 72,655 SF

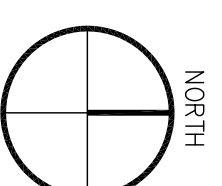

SUITES #100, #200, #205, & #900 - PLAN
 SCALE: 1" = 20'-0"

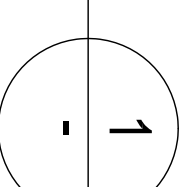

1

