




ARCHITECTURE INC  
 JAA ARCHITECTURE INC.  
 2716 ST. JOHN'S AVE  
 JACKSONVILLE FL 32205  
 P: (904) 379-5108  
 E: JOHN@JAAARCHITECTURE.COM  
 LIC. AR92748


THIS DOCUMENT, ALONG WITH ASSOCIATED DOCUMENTS, IS AN INSTRUMENT OF DESIGNER'S SERVICE FOR THE EXCLUSIVE USE AT THE PROJECT TITLED HEREIN. INFORMATION DERIVED FROM THIS DOCUMENT, AND/OR ASSOCIATED DOCUMENTS, MAY NOT BE USED FOR OTHER WORK(S) OR PROJECT(S) WITHOUT THE EXPRESS WRITTEN PERMISSION OF THE DESIGNER.

AS-BUILT  
**HAKIMIAN HOLDINGS**  
 10210 SAN JOSE BLVD #2  
 JACKSONVILLE, FL 32257

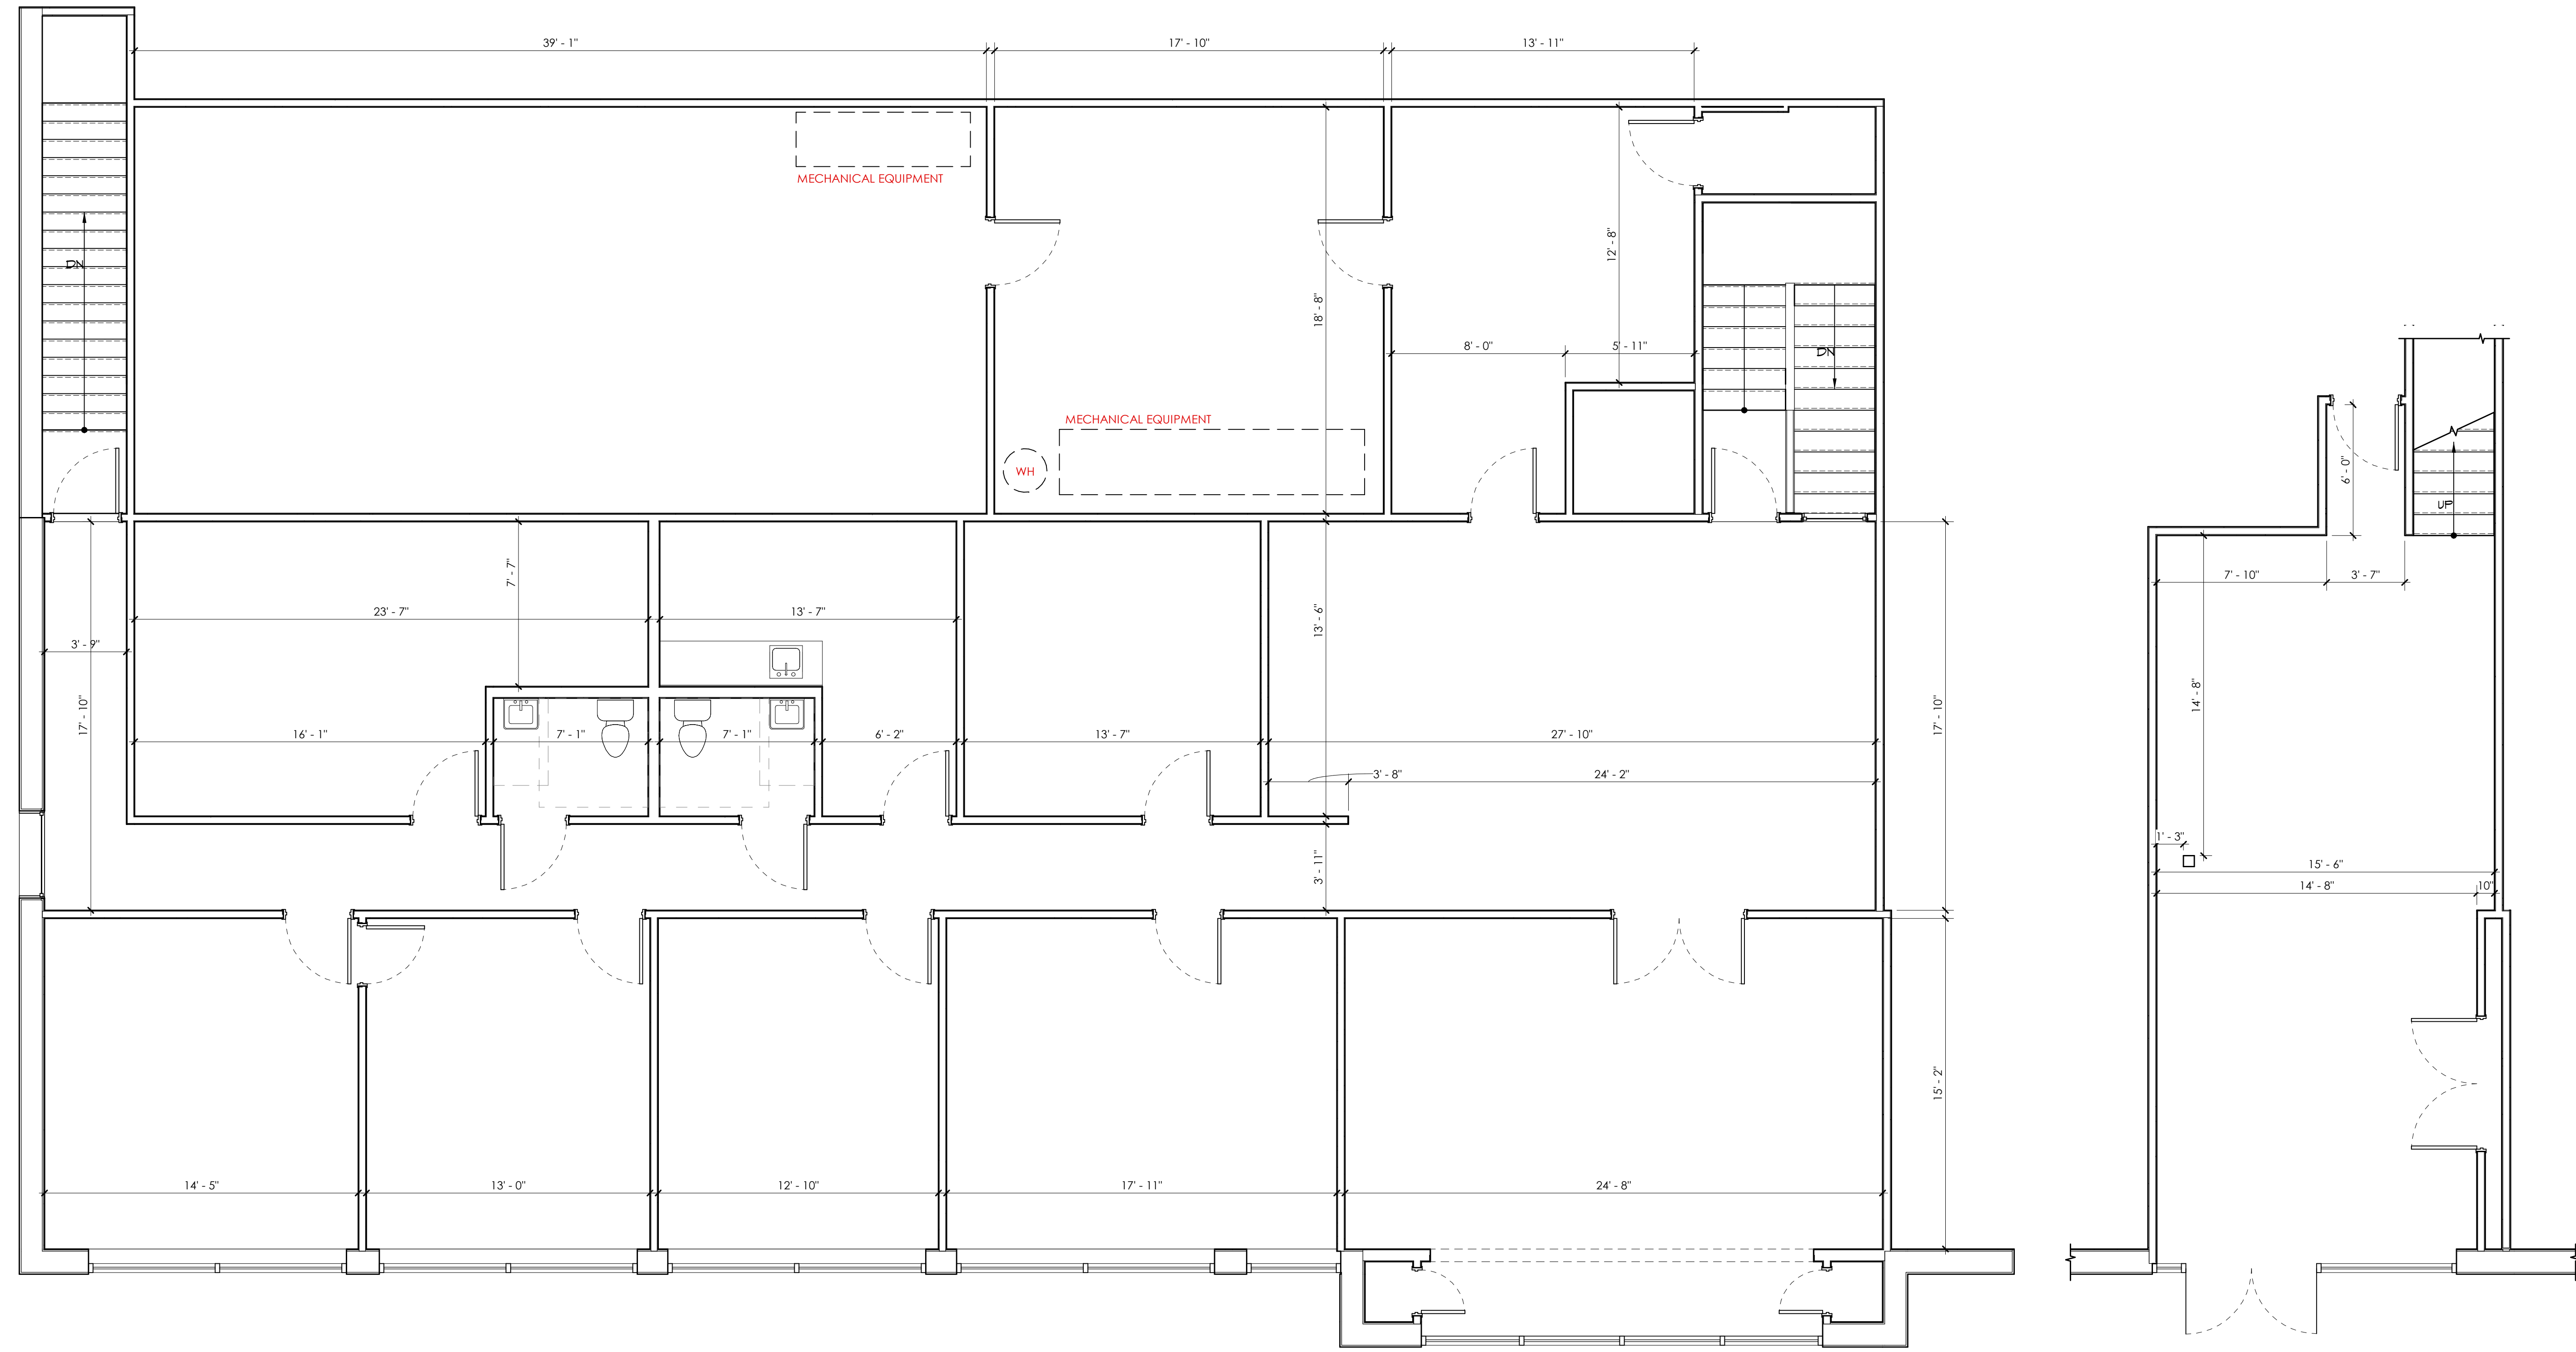

② SECOND FLOOR  
 1/4" = 1'-0"

① LOBBY  
 1/4" = 1'-0"

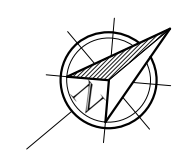

REVISIONS

#	DATE	DESCRIPTION

**NOT FOR CONSTRUCTION**

DATE: 11.8.2017  
 SHEET: FLOOR PLAN

**A101**