


# CHAMBER BUILDING

110 West C Street  
San Diego, CA 92101

9.24.2009

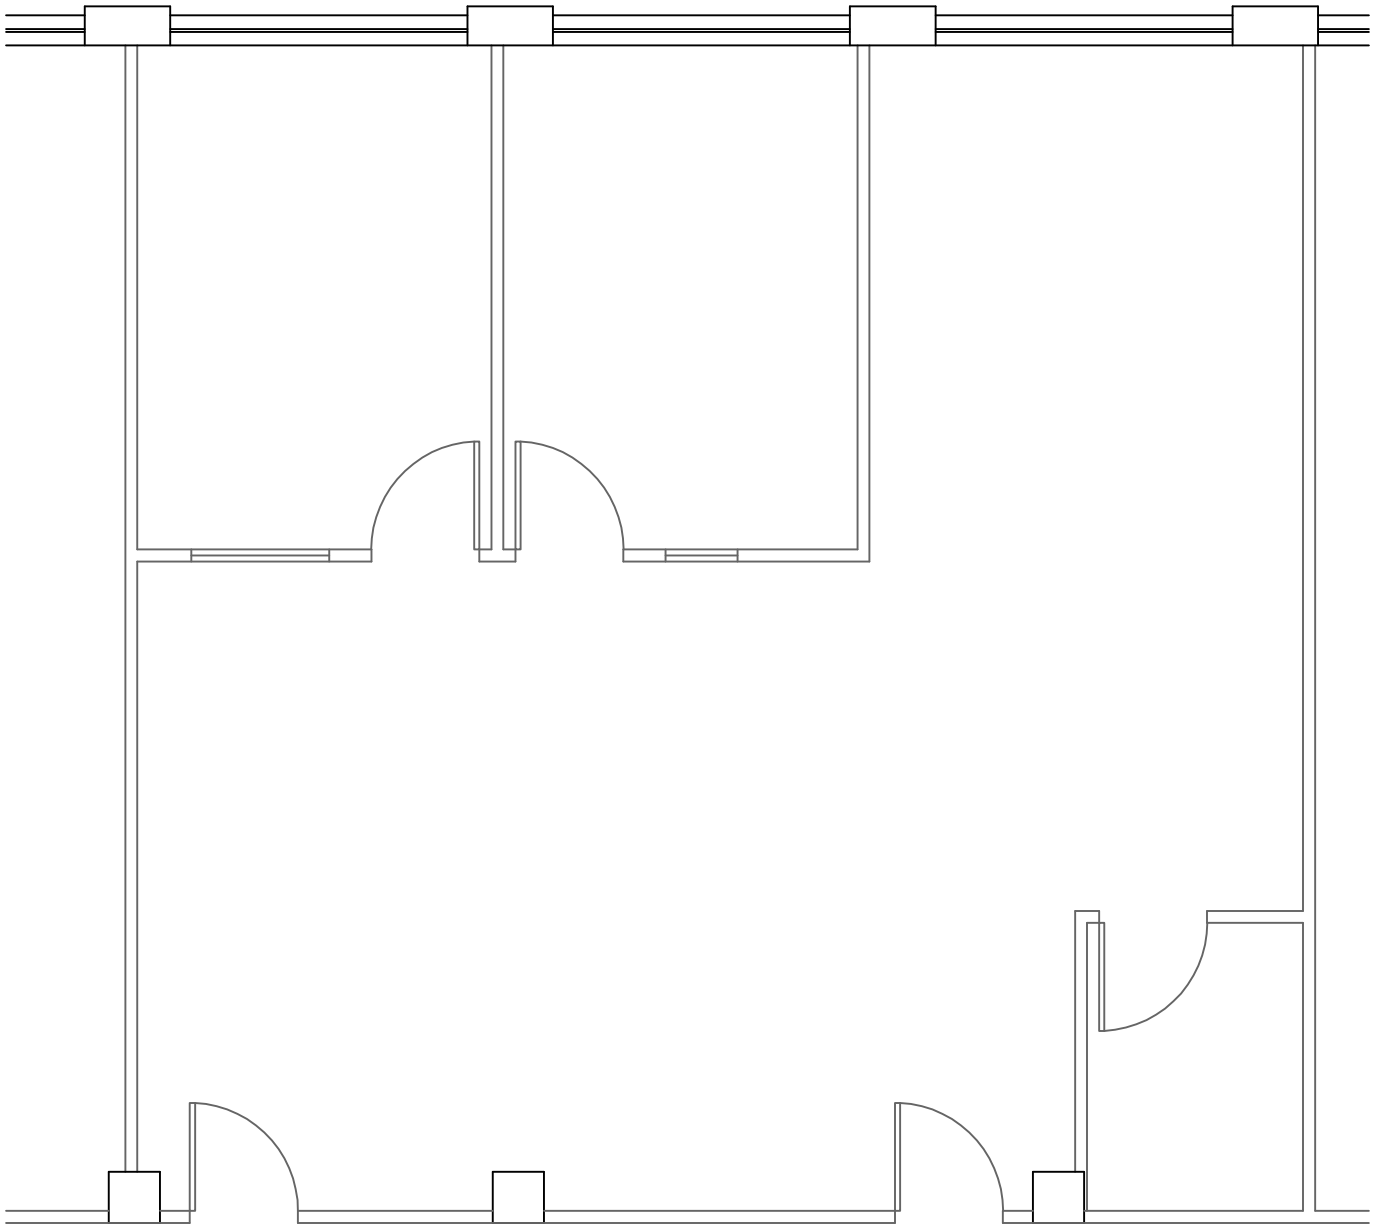

## SPACE PLAN - Suite 1015

SCALED TO FIT