


Park & Polk
4105 - 4107 Park Blvd.
San Diego, CA 92104
11.15.2010

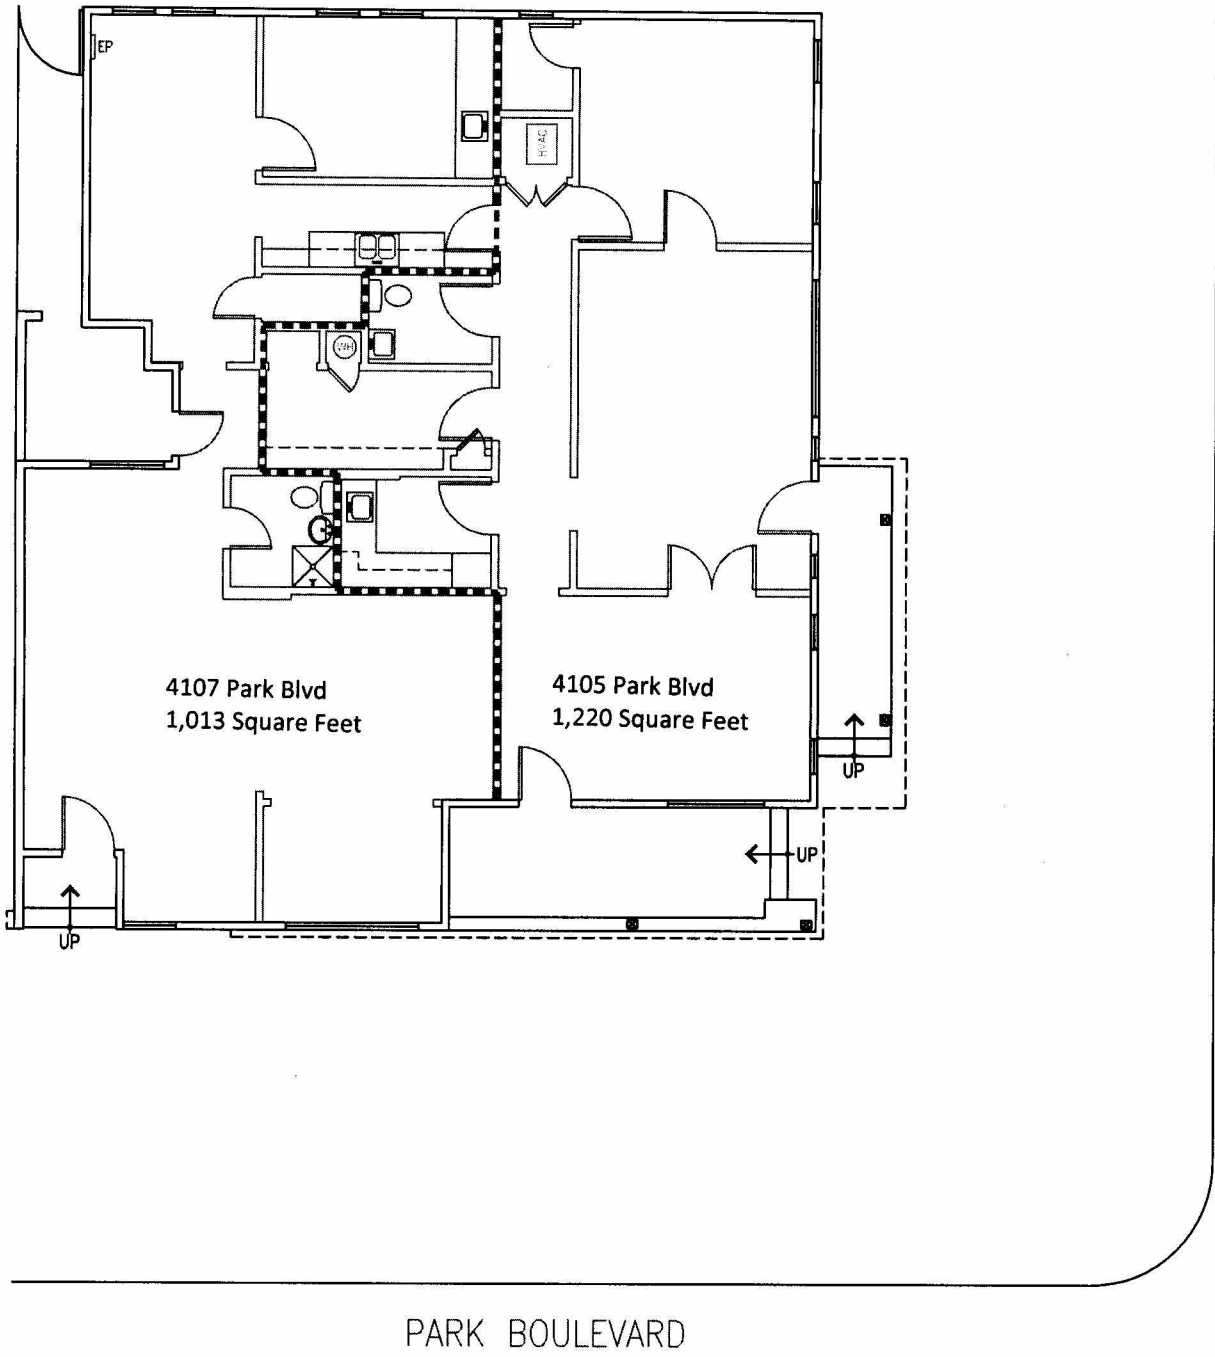

AS BUILT
SCALED TO FIT