


HUTCHINGS/CARRIER, INC.

EMail: kcreatestate@sbcglobal.net

7715 SHAWNEE MISSION PKWY / SUITE 100 / OVERLAND PARK, KANSAS 66202 / 913-432-9800 / FAX 913-432-9818

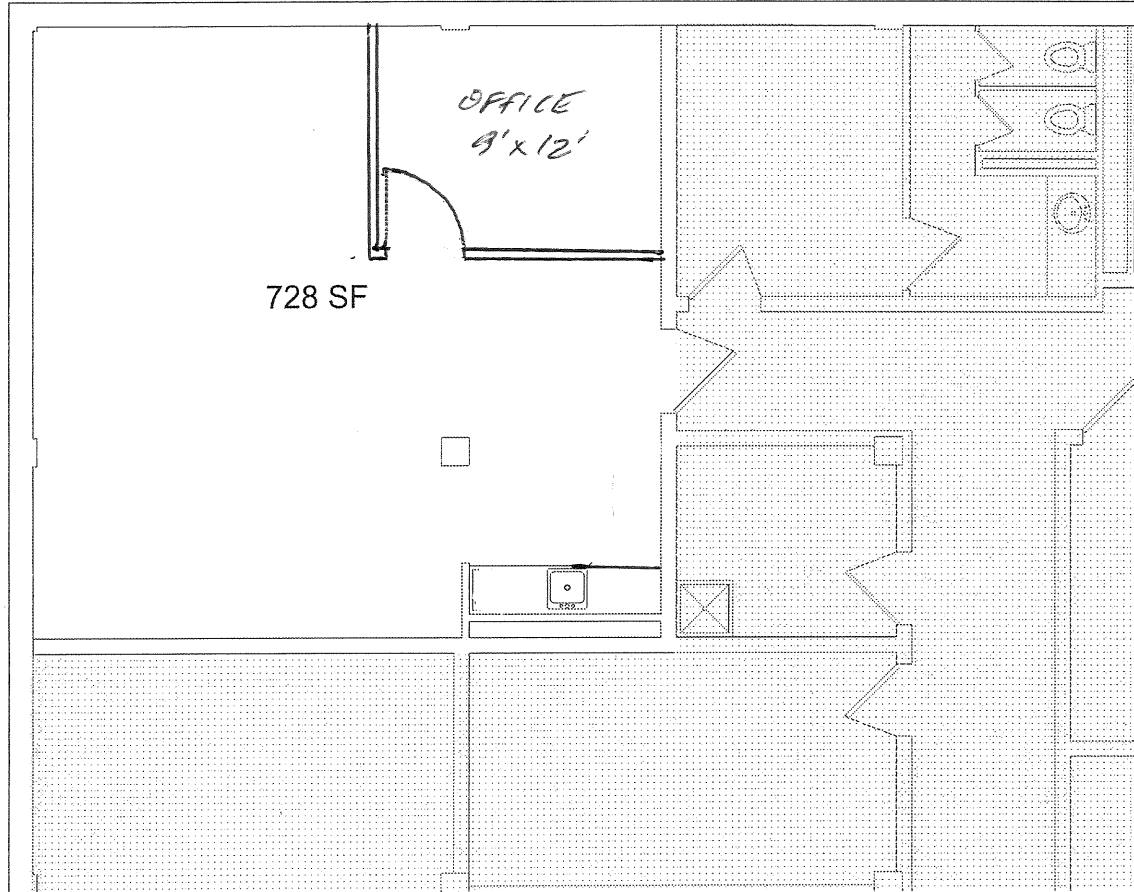

1 LOWER LEVEL FLOOR PLAN

6299 NALL  
AS-BUILT  
6299 NALL AVE. MISSION, KANSAS 66202  
NOT FOR CONSTRUCTION  
SHEET TITLE & NUMBER  
LOWER LEVEL FLOOR PLAN  
A-101

6299 NALL  
MISSION, KANSAS  
728 SF \$595/month, FULL SERVICE