


FLOOR PLAN

BUILDING III

SUITE 120

AS BUILT

3,872 RSF

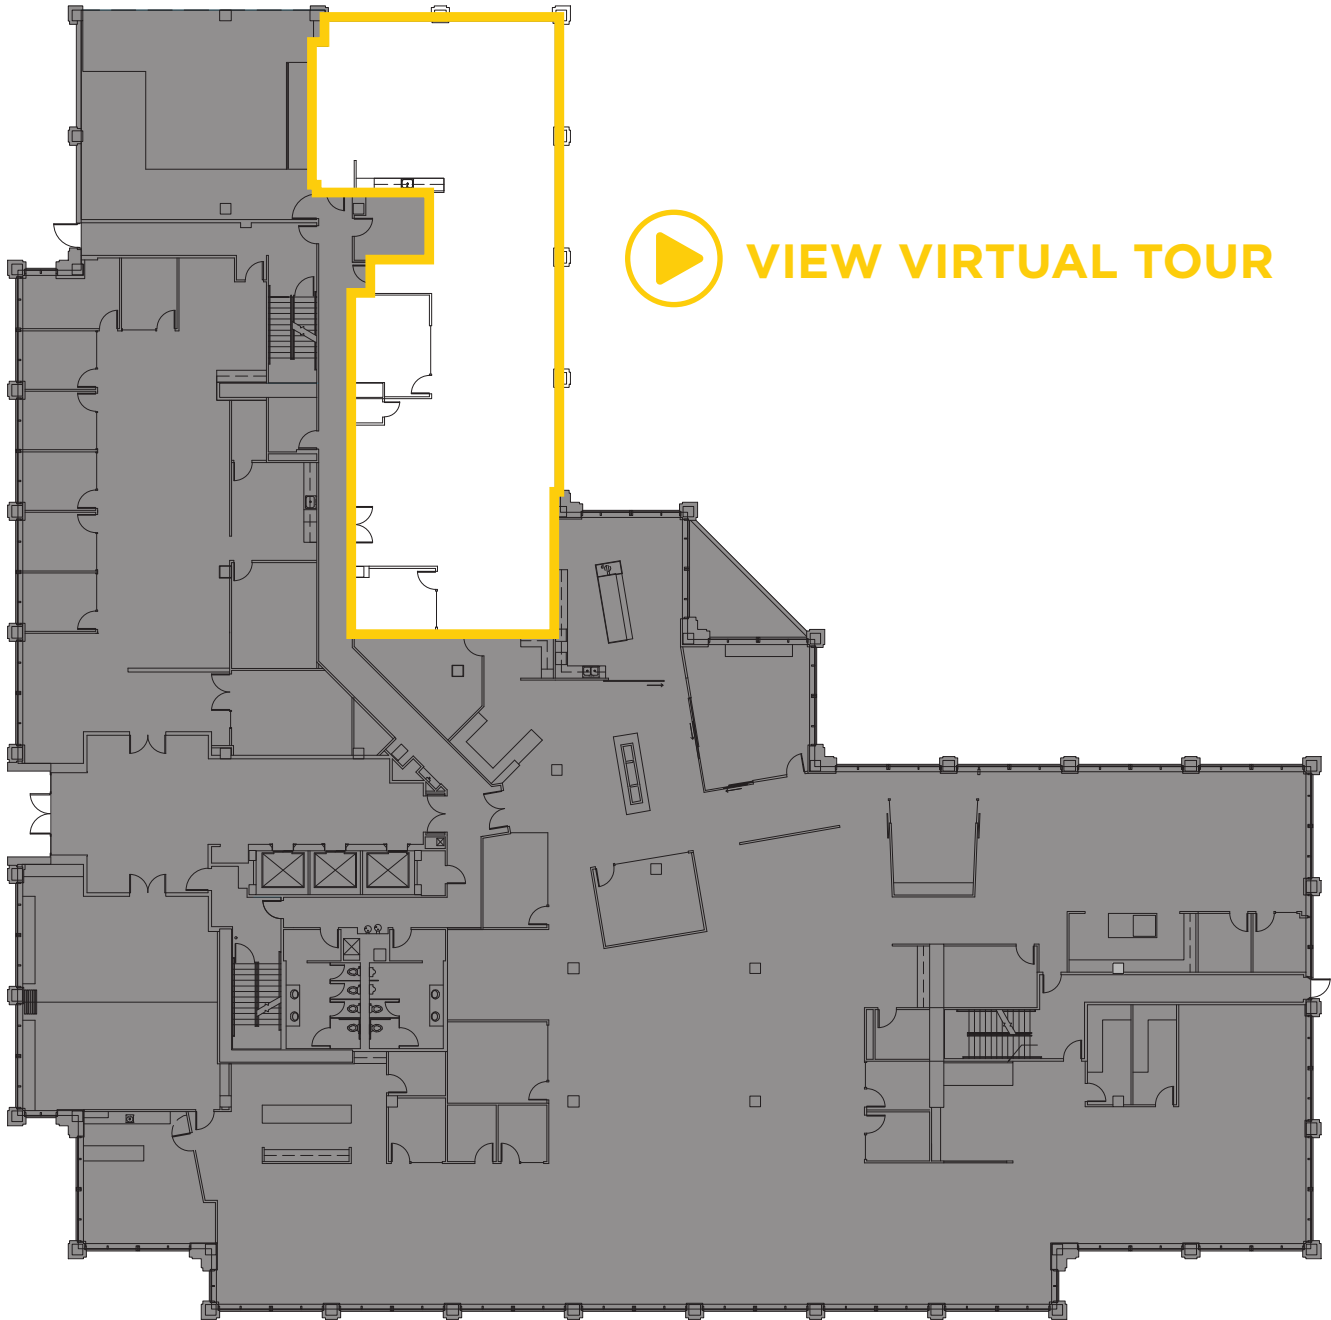

The information contained herein has been given to us by the owner or sources that we deem reliable. We have no reason to doubt its accuracy, but we do not guarantee it. Prospective tenants should carefully verify all information contained herein.

Broderick Group, Inc.

Paul Sweeney + Jason Furr + Tony Ulacia

425.646.3444


FLOOR PLAN

BUILDING III

SUITE 120

PROPOSED LAYOUT

3,872 RSF

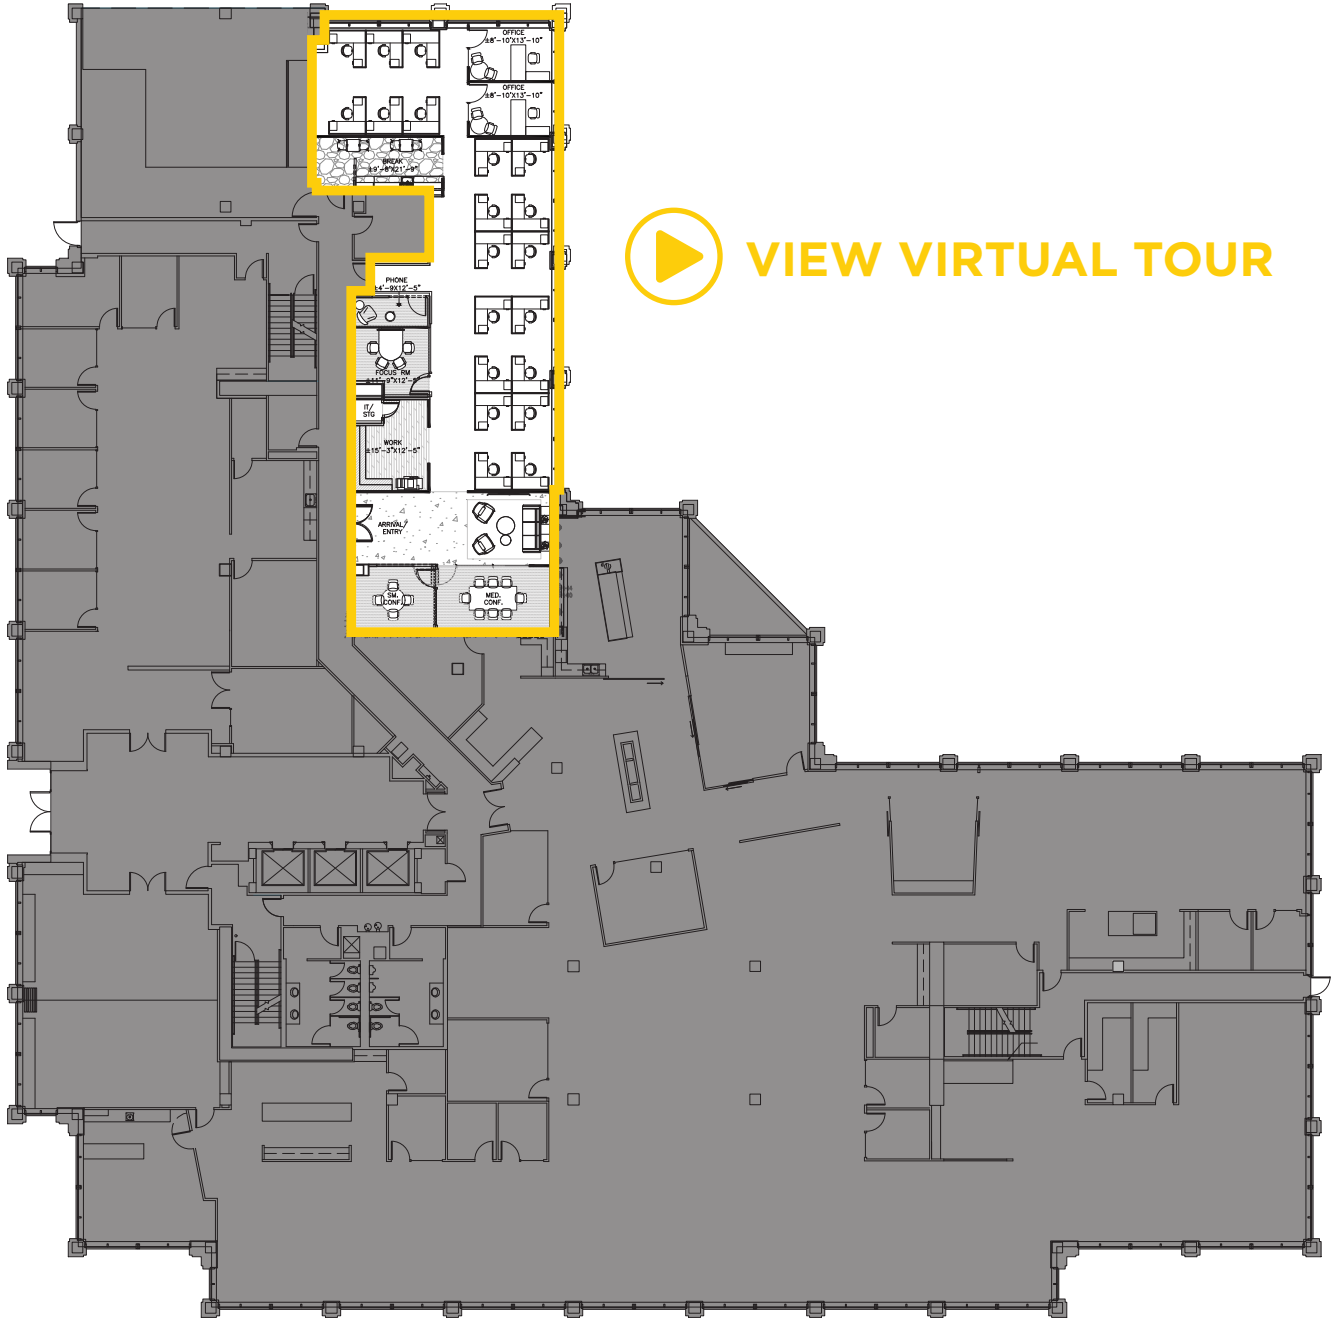

VIEW VIRTUAL TOUR