



# SUITE 203

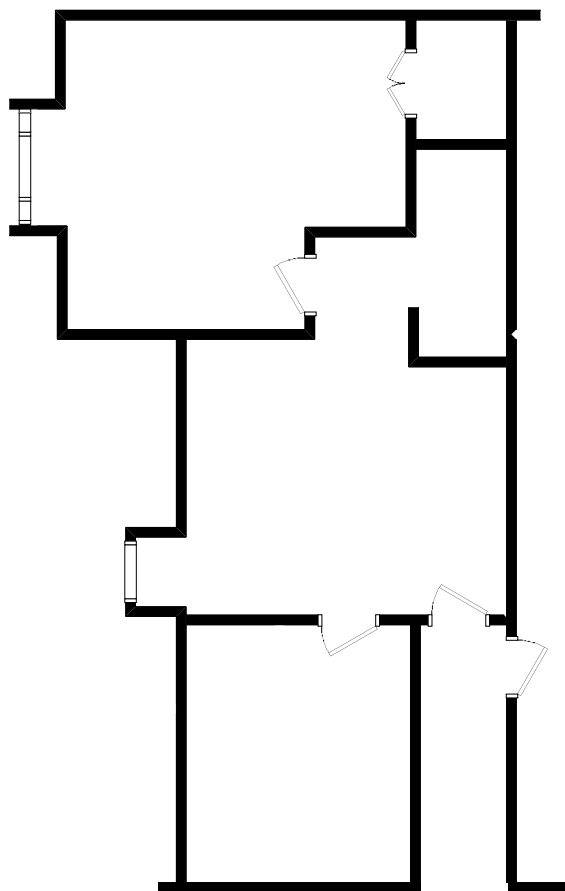


0 5 10  
SCALE IN FEET

## BUILDING 45 - 2ND FLOOR KEY PLAN

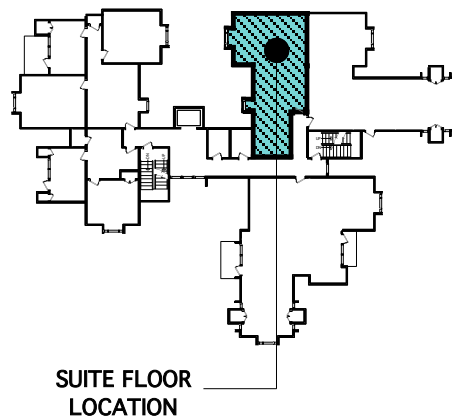


SUITE FLOOR  
LOCATION

## LOCATION BUILDING 45

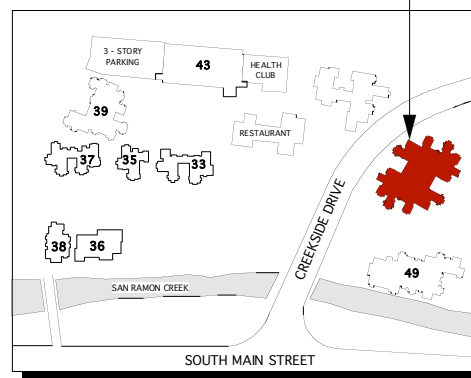

## BUILDING KEY PLAN

Leased by

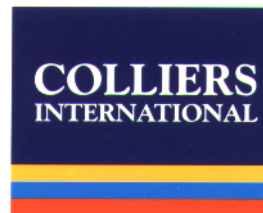

1850 MT. DIABLO BLVD  
SUITE 200  
WALNUT CREEK, CA  
94596

VOICE: (925) 279-0120  
FAX: (925) 279-0450

ERIC ERICKSON  
(925) 279-5580

PETER GUTZWILLER  
(925) 279-4604

## QUAIL COURT OFFICE PARK

WALNUT CREEK, CA

Owned and Managed by:

WESTLAKE  
DEVELOPMENT  
COMPANY, INC.

APPROXIMATE AREA  
CALCULATIONS  
SUBJECT TO VERIFICATION:

645 RSF

AS-BUILT PLAN  
TO BE VERIFIED

THIS INFORMATION DISPLAYED WHILE NOT  
GUARANTEED HAS BEEN SECURED BY SOURCES  
WE BELIEVE TO BE RELIABLE. THIS INFORMATION  
IS SUBJECT TO ERRORS & OMISSIONS. ANY  
TENANT SHOULD CONDUCT THEIR OWN  
INVESTIGATION.

PLAN - A 11/10/04