


FORMER HART BUILDING

220 6th Street
Kirkland, Washington

1,416 RSF FOR LEASE

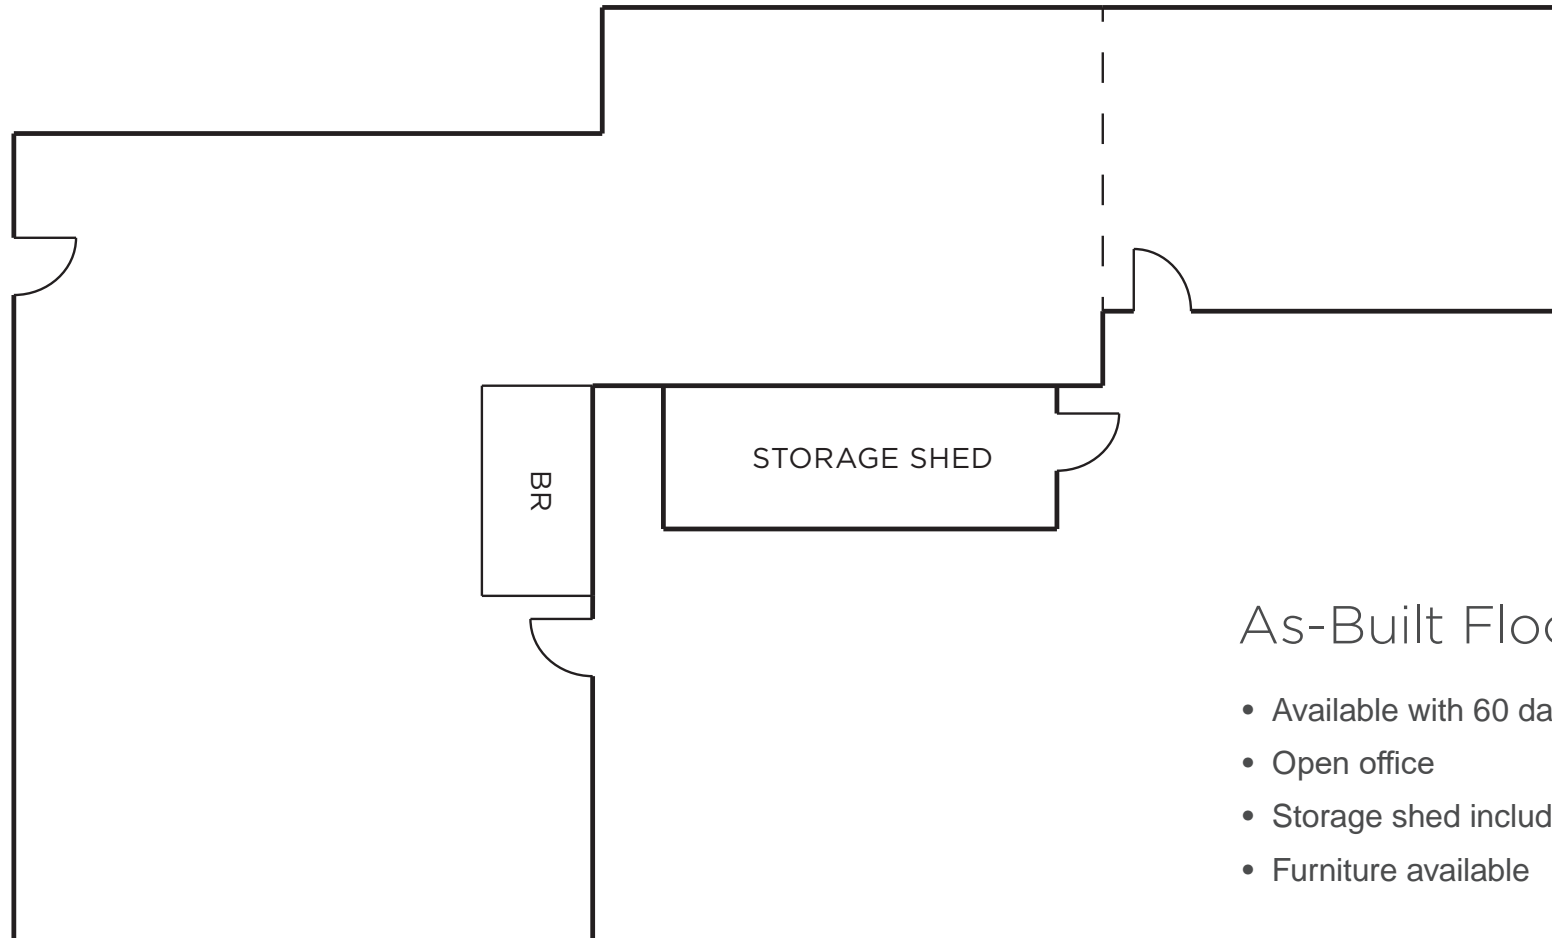

As-Built Floor Plan

- Available with 60 days' notice
- Open office
- Storage shed included
- Furniture available



Commercial Real Estate Services

10500 NE 8th Street, Suite 900
Bellevue, Washington 98004
office: 425. 646. 3444
broderickgroup.com

For further information or to schedule a tour, please contact:

Connor Gilchrist

(425) 274-4286

gilchrist@broderickgroup.com

The information contained herein has been given to us by the owner or sources which we deem reliable. We have no reason to doubt its accuracy, but we do not guarantee it. Prospective tenants should carefully verify all information contained herein.

