

FOR LEASE

2457 SILVERSTAR ROAD., ORLANDO, FL 32804
OFFICE WAREHOUSE FLEX BUILDING FOR LEASE



Lease Rate: \$8.95 PSF MODIFIED GROSS

BUILDING FEATURES

- 7,003 Total Square Feet including: 3,212 SF of Office Space
- Dock High and Grade Level
- 16' Clear Ceiling Height
- 15 Reserved Parking Spaces
- Frontage on Silver Star Rd between John Young Parkway and Highway 441
- "As-Built" Plan Attached



RESULTS REAL ESTATE PARTNERS, LLC
Licensed Commercial Real Estate Brokers

108 Commerce St, Suite 200
Lake Mary, FL 32746
Office (407) 647-0200
Fax (407) 647-0205
www.ResultsREPartners.com


Contact Exclusive Agent:

Jeff Gindi, Broker/Principal
407.925.4464 Cell

JeffGindi@ResultsREPartners.com

This information is from sources we deem reliable and is subject to prior sale, lease, withdrawal without notice, or change in prices, rates, or conditions.
No representation is made as to the accuracy of any information furnished.

AREA MAP

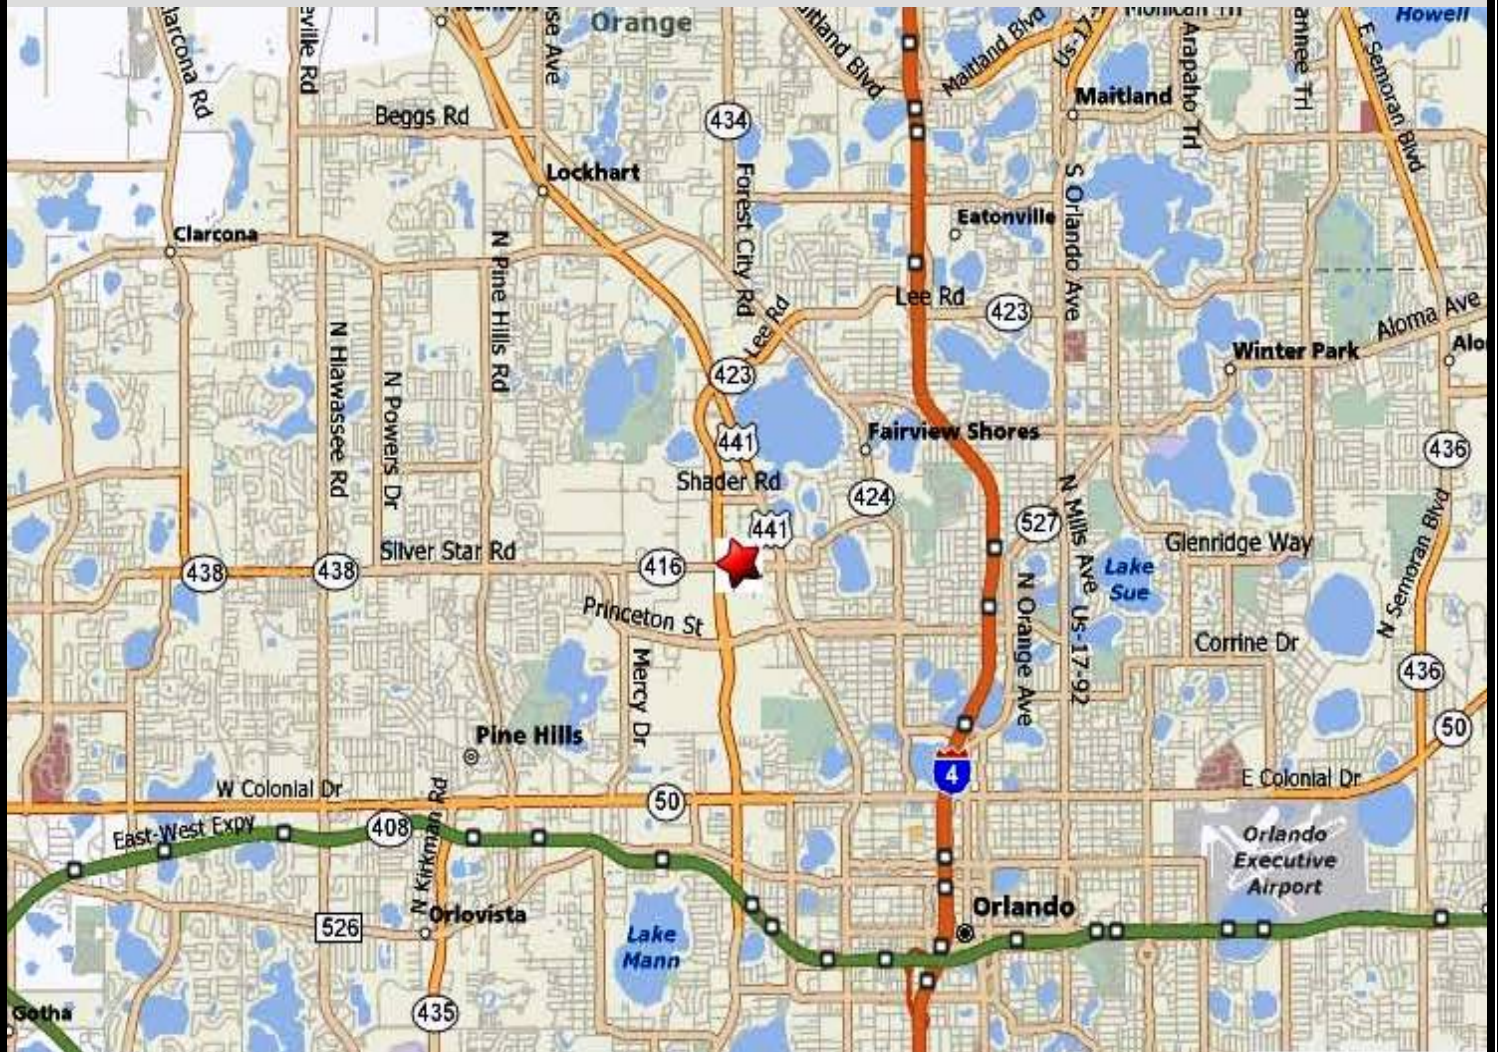

Contact Exclusive Agent:

Jeff Gindi, Broker/Principal
407.925.4464 Cell

JeffGindi@ResultsREPartners.com




RESULTS REAL ESTATE PARTNERS, LLC
Licensed Commercial Real Estate Brokers

108 Commerce St, Suite 200
Lake Mary, FL 32746
Office (407) 647-0200
Fax (407) 647-0205
www.ResultsREPartners.com

This information is from sources we deem reliable and is subject to prior sale, lease, withdrawal without notice, or change in prices, rates, or conditions.
No representation is made as to the accuracy of any information furnished.

FLOOR PLAN

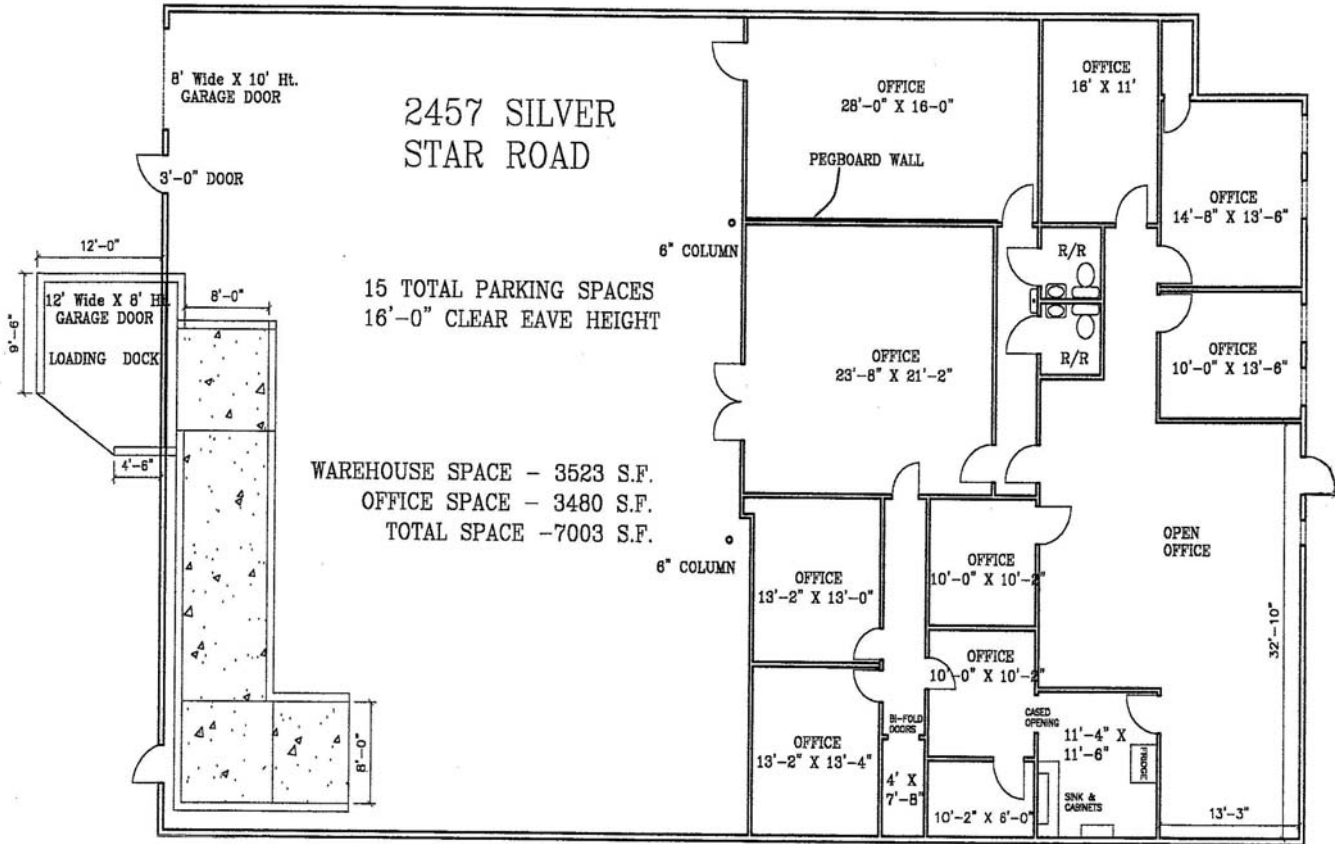

Contact Exclusive Agent:

Jeff Gindi, Broker/Principal

407.925.4464 Cell

JeffGindi@ResultsREPartners.com



RESULTS REAL ESTATE PARTNERS, LLC
Licensed Commercial Real Estate Brokers

108 Commerce St, Suite 200

Lake Mary, FL 32746

Office (407) 647-0200

Fax (407) 647-0205

www.ResultsREPartners.com

This information is from sources we deem reliable and is subject to prior sale, lease, withdrawal without notice, or change in prices, rates, or conditions. No representation is made as to the accuracy of any information furnished.