


① **SUITE 205**  
1/8" = 1'-0"



② **SUITE 205 KEYPLAN**  
1" = 60'-0"

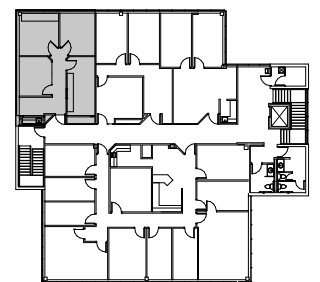

As indicated



PRIME MANAGEMENT

**SUITE 205 AS-BUILT**  
7345 S. PIERCE STREET, LITTLETON, CO 80128

