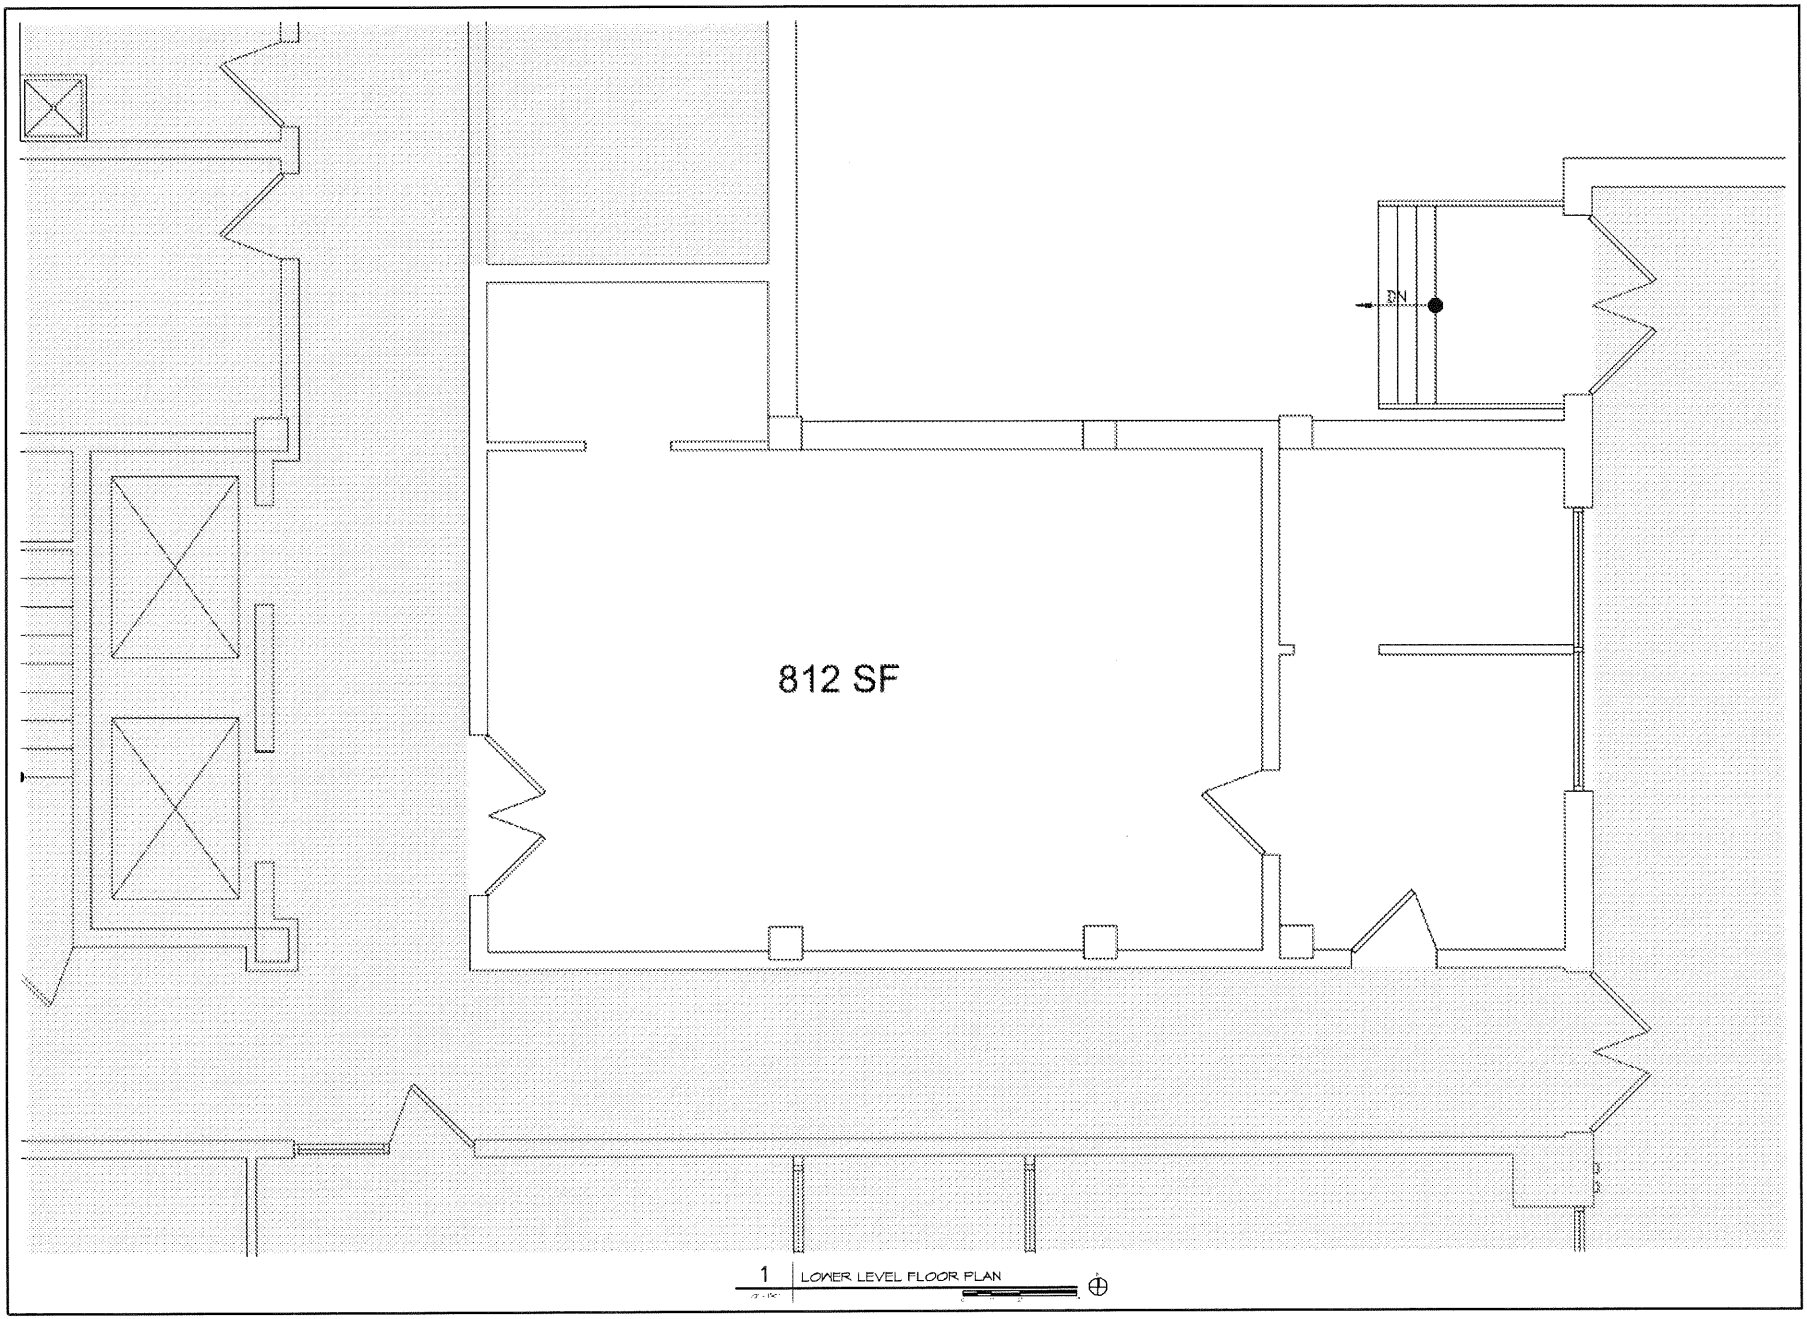

1 LOWER LEVEL FLOOR PLAN

PIPER-WIND ARCHITECTS, INC.

6299 NALL

AS-BUILT

6299 NALL AVE, MISSION, KANSAS 66202

NOT FOR CONSTRUCTION

SHEET TITLE & NUMBER

LOWER LEVEL FLOOR PLAN

COPYRIGHT © 2014 PIPER-WIND ARCHITECTS, INC.

A-101