

American Building
Calculations

23110 State Road 54
Suite 252
Lutz, FL 33549
813-600-5472
www.abccalc.biz


Client:
1801 N. Military Tr
Suite 202
Boca Raton, FL 33431
561.893.6252

Property:
2800 Weston
2800 Weston Rd
Weston, FL 33331

This is an unpublished existing condition measurement / as-built floor plan document created by American Building Calculations, Inc. Any site plans are outlines only and are not to be considered valid engineering drawings. This document has been created based on the contract for this project agreed upon between the owner and American Building Calculations, Inc. Any publication, copying, distribution or exhibiting of this document with attributes identifying American Building Calculations, Inc. is not permitted in any fashion without the written permission of American Building Calculations, Inc.

Field Drawn By:	JM
Drawn By:	JM
Published Date:	10/26/15
Revision Date:	N/A

Scale:
Custom

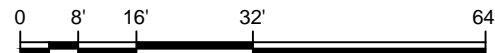

SECOND FLOOR
FLOOR PLAN