#2420
AVAILABLE
5318 USF
6142 RSF

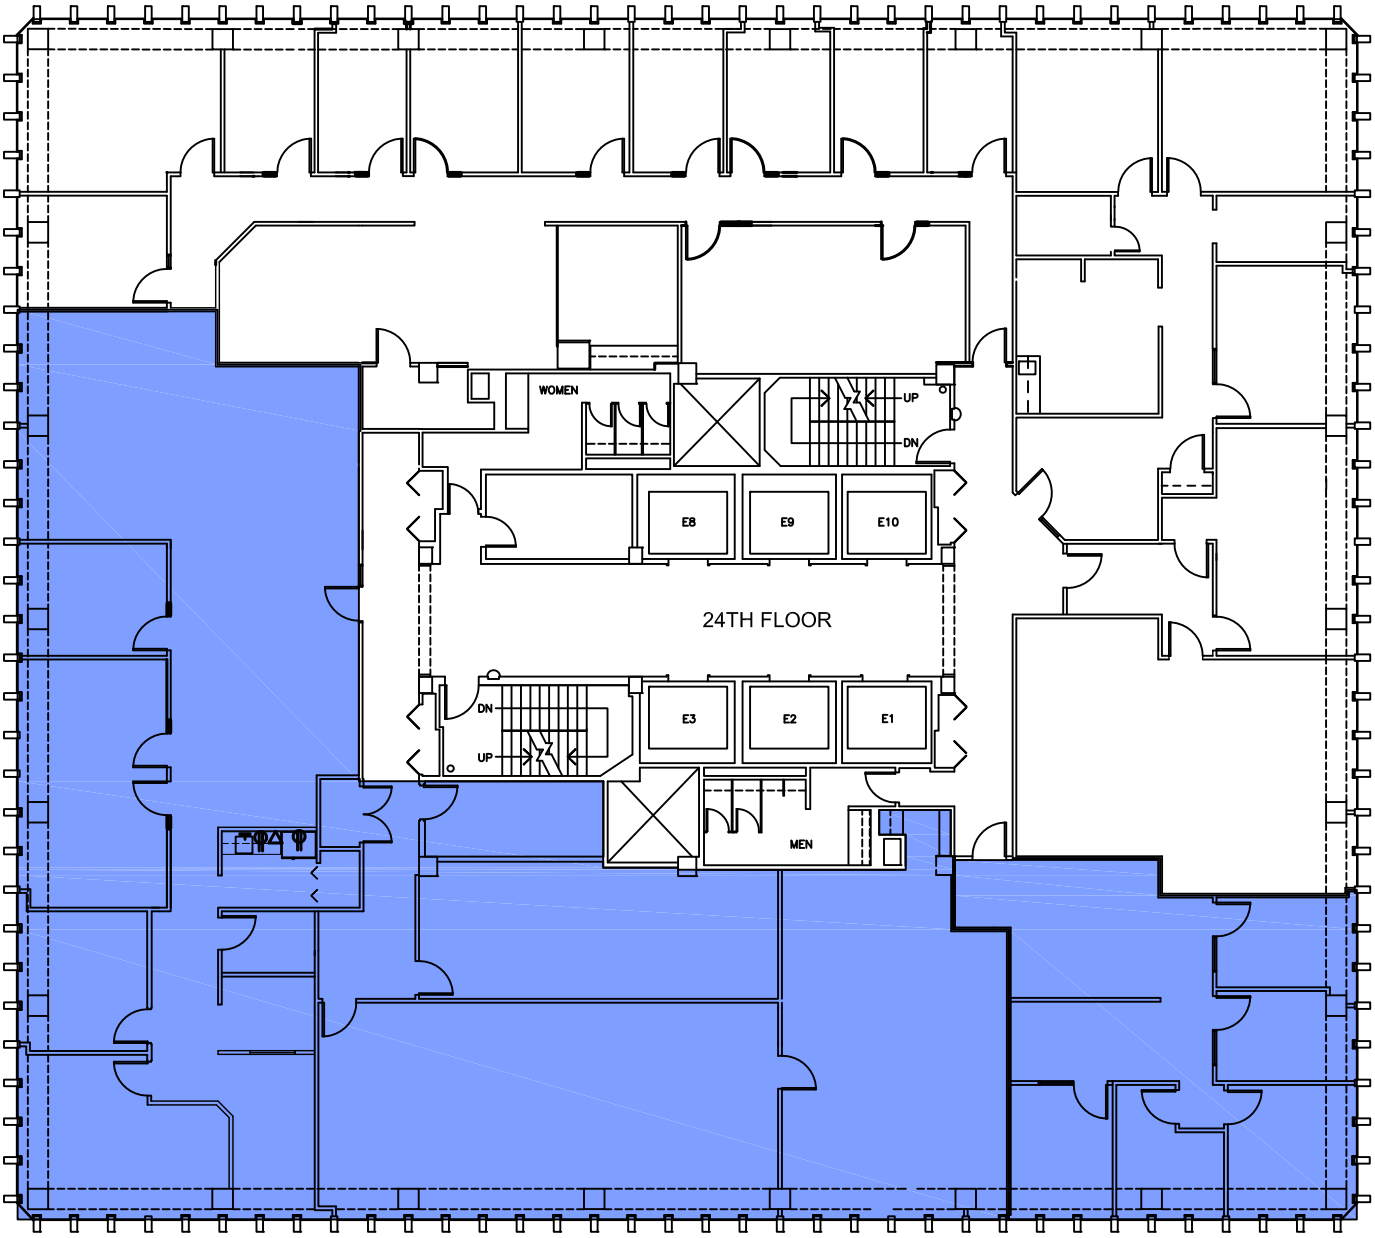

AS-BUILT FLOOR PLAN

NOT TO SCALE

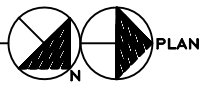

westin building EXCHANGE